

WATER SERVICE RECORD

Name

Service No.

Address

62 Farmcrest Avenue

Location

Repair—Renewal—New Service

Date	Material	Amount	Total	Date	Amount
------	----------	--------	-------	------	--------

OUTSIDE

1985 27' 3/4" Copper

4' 1" Copper

1" Corp


3/4" x 1" Reducer

DATE _____

TOWN OF LEXINGTON — BOARD OF PUBLIC WORKS

WATER DIVISION

Sketch of Service Here

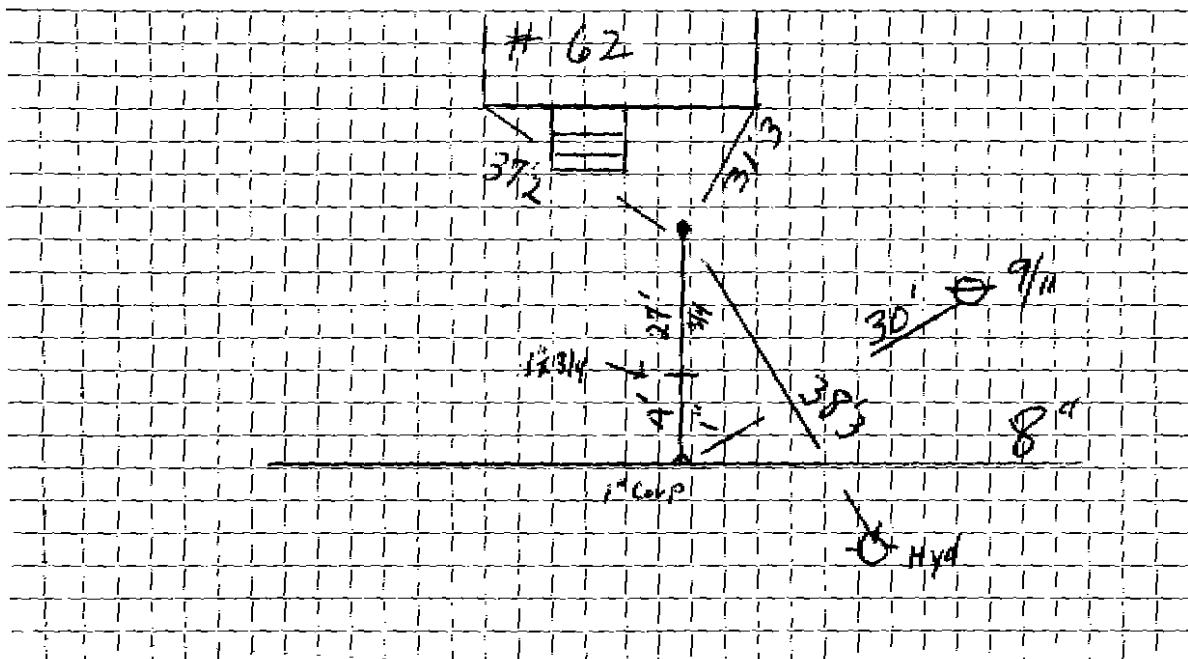

Connection made in Street. Work completed

Remarks: