

WATER SERVICE RECORD

Name John Spilewski

Service No. 150

Address 63 Farmcrest Avenue

Location

~~REPAIR—Renewal—REPAIRS~~


Comm 12-4-61

Date	Material	Amount	Total	Date	Amount	
10-26-61	Labor	49.74		10-4-61	Deposit	200.00
10-28-61	"	2.13	51.87	12-4-61	Refund	98.25
	10% O.H.	5.19	57.06			101.65
38'	1" Copper tubing @.56		21.28		NON CHARGE	
1	1" x 1" I.W.H. Stop & Waste		6.96	10-28-61	Labor	13.65
1½	hr. Town Shovel @6.50		9.75	10'	1" Copper tubing @.56	5.60
2	hrs. Trucking @3.00		6.00	1	1" Gurb Cock	8.06
			101.05	1	1" Adapter	3.29
				1	Box & Rod	4.90
				1	3/4" 8 x 1" 3 Part Union	3.98
				7 x 3	Patch	7.00
				½	hr. Town Shovel @6.50	3.25
				1	hr. Trucking @3.00	3.00
					1" Corp	52.73

DATE _____

TOWN OF LEXINGTON — BOARD OF PUBLIC WORKS
WATER DIVISION

Sketch of Service Here

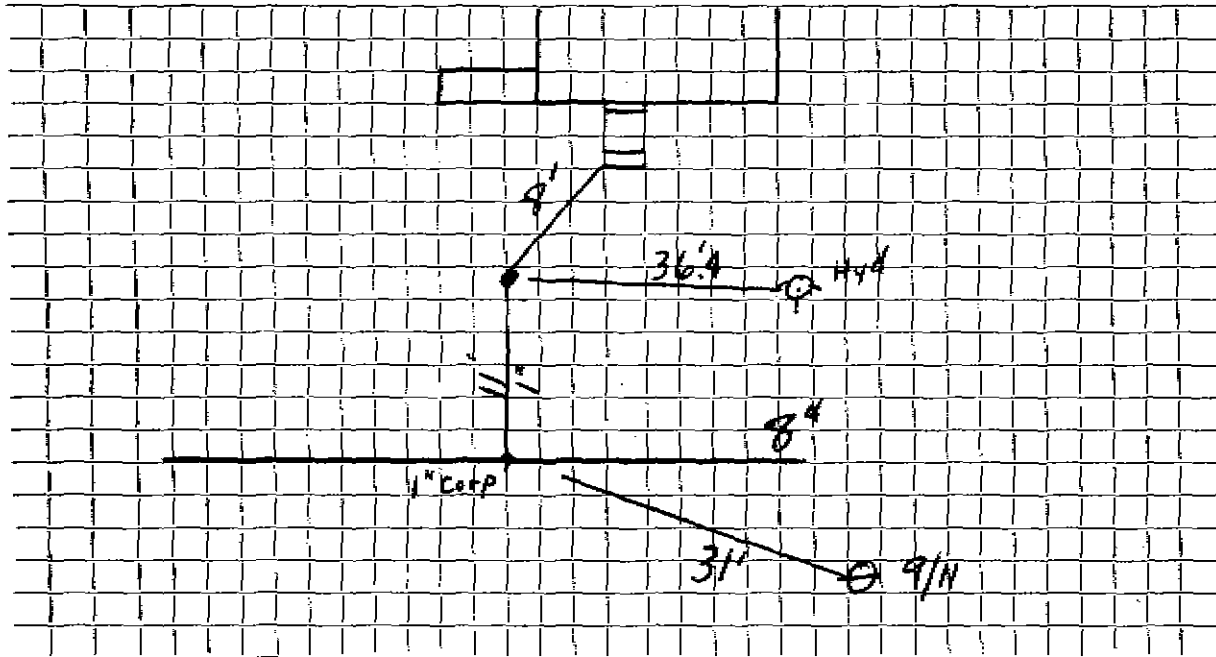

Connection made in Street. Work completed

Remarks:
.....
.....