

WATER SERVICE RECORD

Name

Service No.

Address

67 Farmcrest Avenue

Location

Repair—Renewal—New Service


Date	Material	Amount	Total	Date	Material	Amount
<i>5/2/69</i>	<i>22' 3/4" Copper tubing</i>					
	<i>1 3/4" Union</i>					
					<i>OUTSIDE</i>	
				<i>1985</i>	<i>4' 1" Copper</i>	
					<i>1" Corp.</i>	
					<i>3/4" x 1" Reducer</i>	
					<i>7' 3/4" Copper</i>	
					<i>3/4" Curb Cock</i>	
					<i>Box & Rod</i>	

DATE _____

TOWN OF LEXINGTON — BOARD OF PUBLIC WORKS

WATER DIVISION

Sketch of Service Here

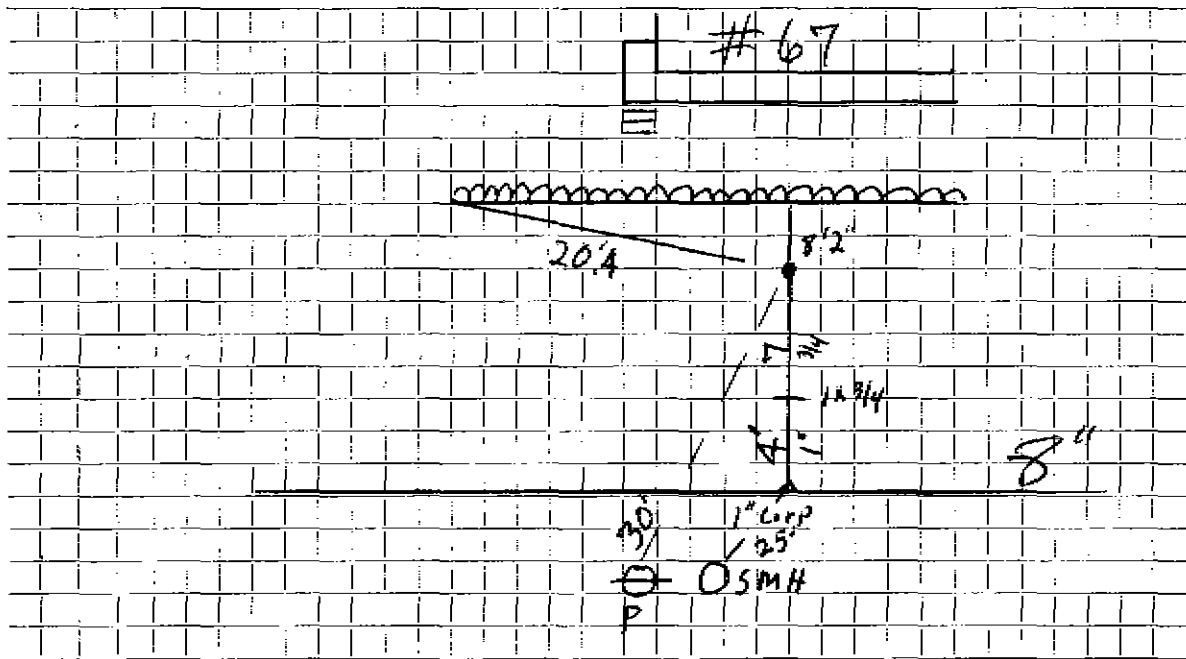

Connection made in Street. Work completed

Remarks:

.....

.....