

Name Frank Battafuoco  
 Address 9 Farmcrest Avenue  
 Lexington

Service No. 118

#1643  
 #1644

Location 9 Farmcrest Avenue

Kind of Pipe  
 Repair—Renewal—New Service  
 Size  
 Size of Main  
 Location

Com. 7-3-50

Date	Material	Amount	Total	Date	Material	Amount
June 13, '50	Labor	1 30	1 30	June 13, '50	Labor	1 30
	10% Overhead		13	July 20, '50	Deposited	20.00
	54' - 3/4" Copper Tubing @.23		12 42		Followed up	
	1 - 3/4" C x 1/2" I.W.H. S&W		3 29		No Charge	17 89
	Trucking 1 hr. @.75		75	June 13, '50	Labor	1 30
			17 89	10' - 3/4" Copper Tubing @.23		2 30
				1 - 3/4" C Corp-cock		3 15
				1 - 3/4" C x 3/4" C Curb-cock		3 85
				1 - Box & Rod		3 35
				1 - 1/2" Offset Tail Piece		38
				1 - 1/2" Straight Tail Piece		38
				Trucking 1 hr. @.75		75
						15 46
	Labor					

Hadley Press, Inc., Lexington

DATE \_\_\_\_\_

# TOWN OF LEXINGTON—BOARD OF PUBLIC WORKS

## WATER DIVISION

The undersigned applies for a supply of water at No. \_\_\_\_\_ St. and hereby agrees to comply with the rules and regulations as now, or at any future time, established by the Board of Sclctmen.

Am't. of Estimate \$ \_\_\_\_\_


Owner \_\_\_\_\_

Am't. Paid \$ \_\_\_\_\_

Address \_\_\_\_\_

Builder \_\_\_\_\_

### Sketch of Service Here

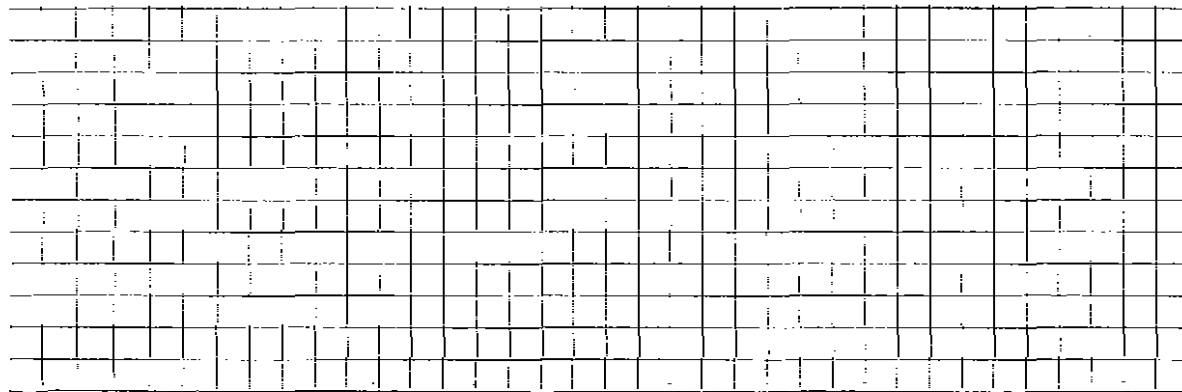

Connection made in \_\_\_\_\_ Street.

Work completed \_\_\_\_\_ 19

Remarks: