

Name Felix F. Blume

Service No.

Address 12 Fern Street

Lexington, Mass.

Location 12 Fern Street

Kind of Pipe

Size

Size of Main

~~Repair~~ ~~Renewal~~ ~~New Service~~

Renewed to 12" Main

Location

Date	Material	Amount	Total	Date	Amount
10-24-92	23.8" 3/4 COPPER				
1	1" L" BRASS NIPPLE			Oct. 15, '18 Labor	1 15
1	3/4 VALVE			16' - 3/4" Copper tubing @ .255	4 08
1	1" BRASS TO COMP ADPT			1 - 3/4" C Corp-cock	3 00
				1 - 3/4" C x 1" I Curb-cock	3 68
				1 - Box & Rod	3 55
					<hr/> 15 46
	Labor				
CONTRACTOR	J.F. GATELY				
PERMIT NO	0646				

TOWN OF LEXINGTON – BOARD OF PUBLIC WORKS

**WATER DIVISION**

The undersigned applies for a supply of water at No..... St. and hereby agrees to comply with the rules and regulations as now, or at any future time, established by the Board of Selectmen.

Am't of Estimate \$.....

Owner .....


Am't Paid \$.....

Address .....

Builder .....

.....

Sketch of Service Here

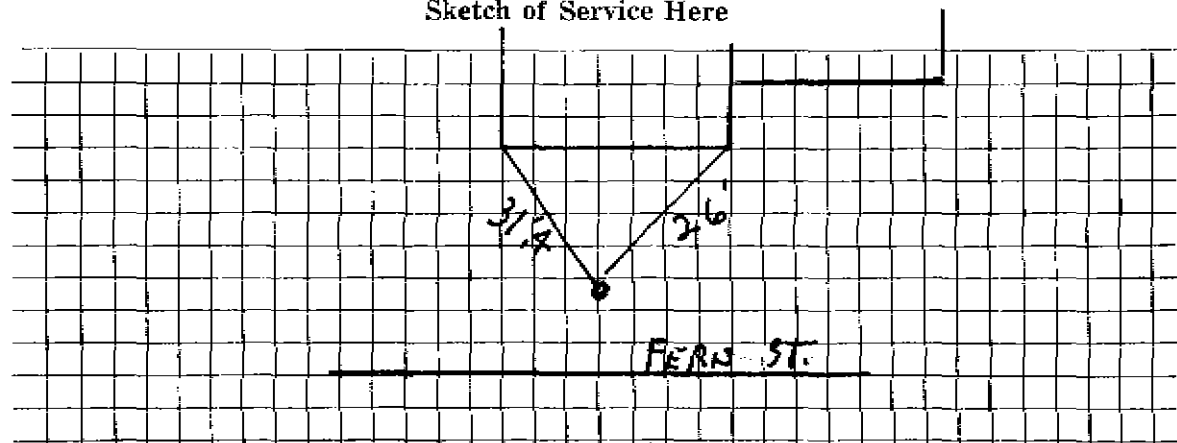

Connection made in ..... Street.

Work completed .....19

Remarks: