

Name Joseph H. Stoney
 Address 15 Fern Street
 Lexington, Mass.

Service No.

Location 15 Fern Street

Kind of Pipe

Size

Size of Main

~~Repair - Renewal - New Service~~

Renewed to 12" Main

Location

Date	Material	Amount	Total	Date		Amount
					Non-Charge	
				Oct. 15, '48	Labor	1 15
				6' - 3/4"	Copper tubing @.255	1 53
				1 - 3/4"	C Corp-cock	3 00
				1 - 3/4"	C x 3/4" Curb-cock	3 68
				1 - 3/4"	Repair Clamp	1 11
						10 47
	Labor					

TOWN OF LEXINGTON - BOARD OF PUBLIC WORKS

WATER DIVISION

The undersigned applies for a supply of water at No. St. and hereby agrees to comply with the rules and regulations as now, or at any future time, established by the Board of Selectmen.

Am't of Estimate \$.....


Owner

Am't Paid \$.....

Address

Builder

Sketch of Service Here

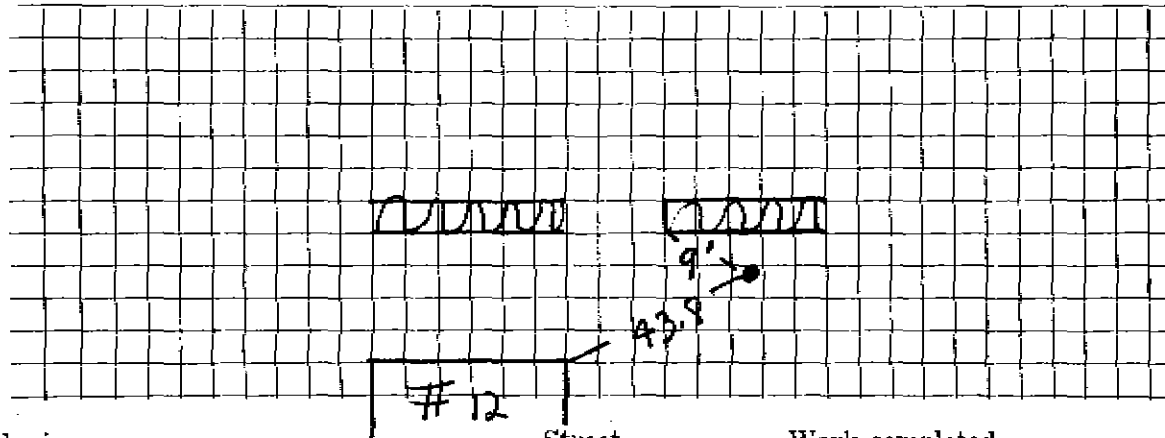

Connection made in Street.

Work completed19

Remarks: