

WATER SERVICE RECORD

Name Mary F. Devereaux

Service No. 36

Address 21 Fern Street

Location

~~Repair~~—Renewal—~~New Service~~ W. O. # 9897 RENEWED 12" MAIN

AUG 14 1972


Date	Material	Amount	Total	Date	Amount
7/6/72	Labor	164 32		7-6-72	350 00
	10% O.H.	16 43	180 75	8-14-72	87 47
50'	3/4" Copper pipe .79		39 50		262 53
1	3/4" Wheel Valve		10 28		
2	Hrs. Trucking 3.00		6 00	1	6' 3/4 COPPER
4	Hrs. Shovel 6.50		26 00	1	3/4 CORP
			262 53	1	3/4 CURB COCK
					Box + Rod

DATE _____

TOWN OF LEXINGTON — BOARD OF PUBLIC WORKS

WATER DIVISION

Sketch of Service Here

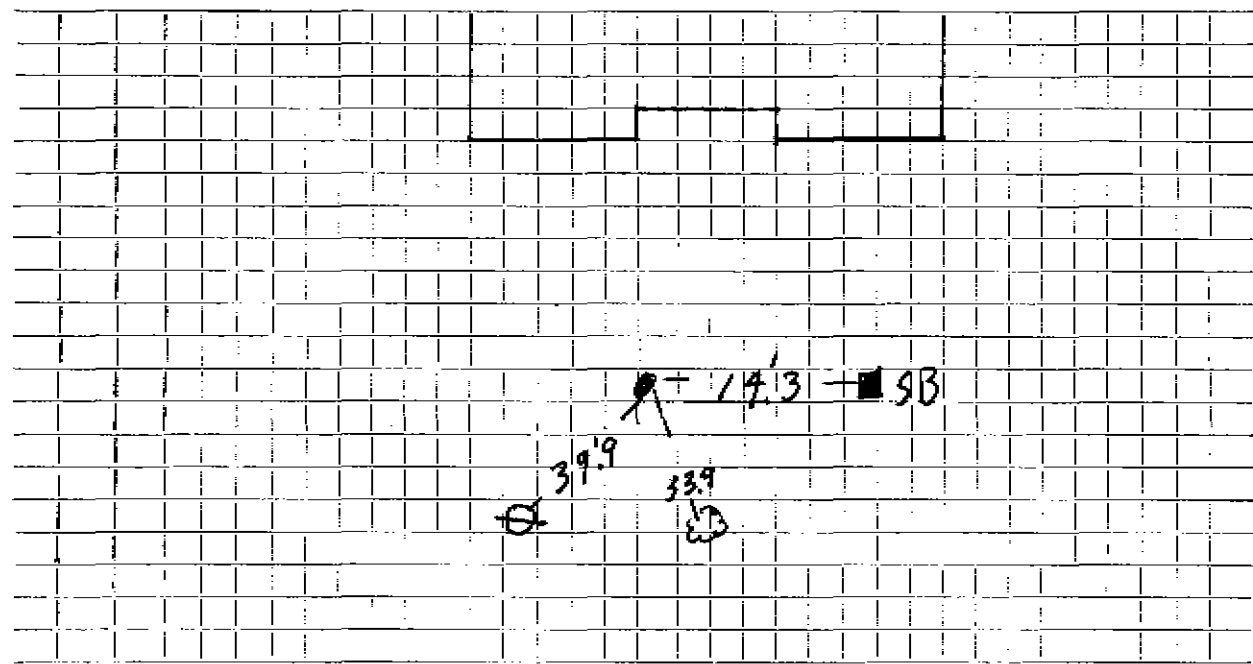

Connection made in Street. Work completed

Remarks:
.....
.....