
WATER SERVICE RECORD Name Al Whiteomb Service No. Address 29 Fern ST Location Revewed to 12" main Repair-Renewal-New Service Date Total Date Material Amount Amount Outside 75.00 "Copper 9-12-00 - 3/4 x 1" Adapt.

TOWN OF LEXINGTON - BOARD OF PUBLIC WORKS

WATER DIVISION

Sketch of Service Here

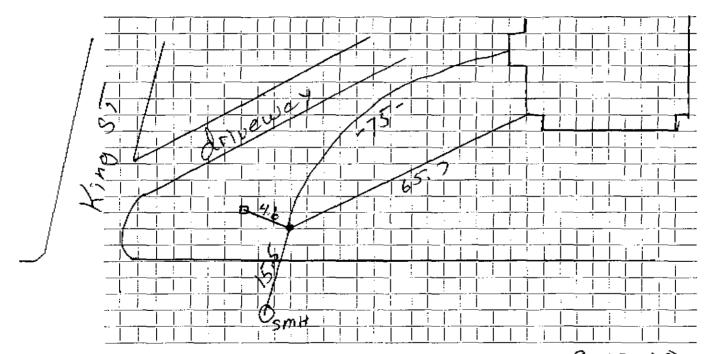

Connection made in	Street.	Work completed	7-12-00
--------------------	---------	----------------	---------

Remarks: