

Name Benjamin S. Stoney

Service No.

#4351

Address 3 Fern Street

Lexington, Mass.

Location 3 Fern Street

Kind of Pipe

Size

Size of Main

~~XXXX~~ Renewal ~~XXXX~~ ~~XXXX~~

Renewed to 12" Main

Location

Date

Material

Amount

Total

Date

Amount

Non-charge

Oct. 15, '48 Labor 1 15

6' - 3/4" Copper tubing @.255 1 53

1 - 3/4" C Corp-cock 3 00

1 - 3/4" C x 3/4" C curb-cock 3 68

1 - 3/4" Repair Clamp 1 11

10 47

OUTSIDE W.O.#1783

7/20/81 4' 3/4" Copper tubing

1 3/4" 3 part Union

1 Box & Rod

Patch 9 x 13

Labor

3 hrs. Trucking

1 1/2 hr. Roller

2 hrs. Town Shovel

DATE _____

TOWN OF LEXINGTON - BOARD OF PUBLIC WORKS

WATER DIVISION

The undersigned applies for a supply of water at No..... St. and hereby agrees to comply with the rules and regulations as now, or at any future time, established by the Board of Selectmen.

Am't of Estimate \$.....

Owner


Am't Paid \$.....

Address

Builder

.....

Sketch of Service Here

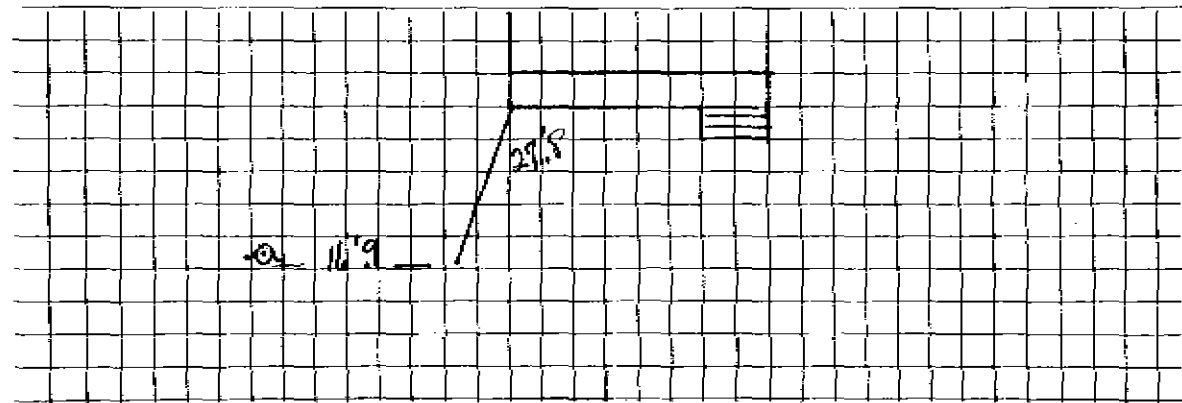

Connection made in Street.

Work completed19

Remarks: