


Date: 06/05/24

TOWN OF LEXINGTON - BOARD OF PUBLIC WORKS
WATER DIVISION

SKETCH OF SERVICE HERE
32 Fern St.

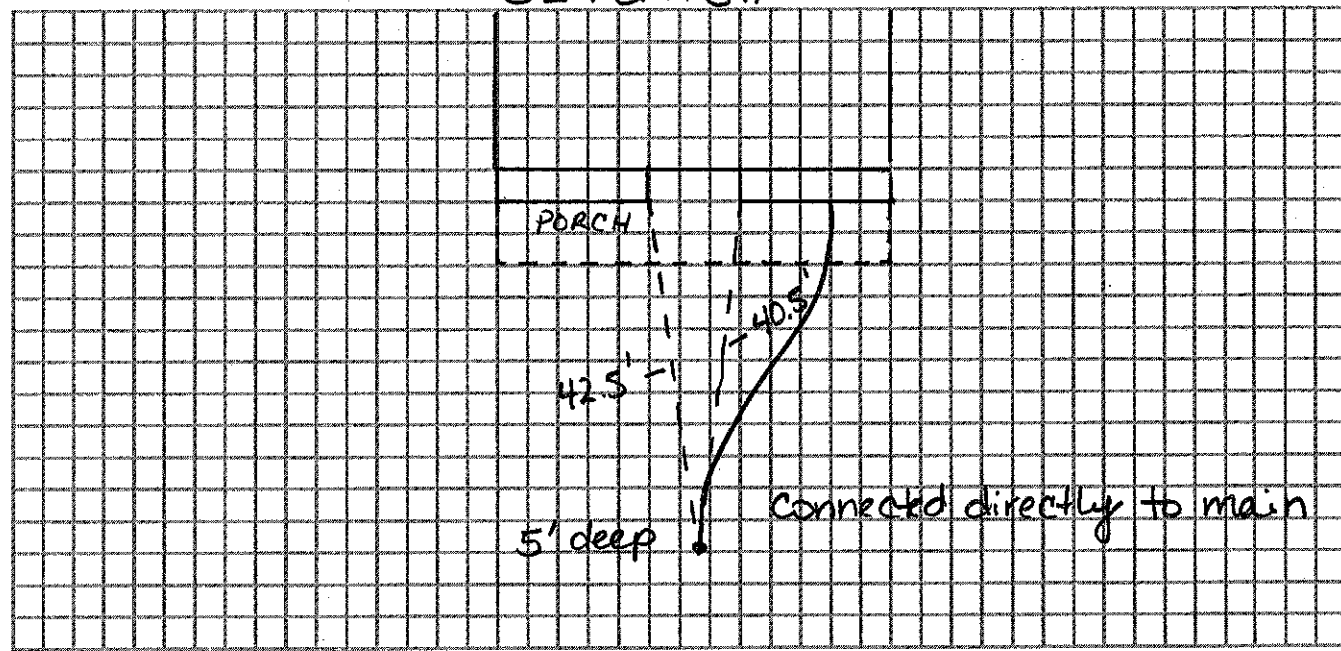

Connection made in:

Street.

Work completed:

Remarks: Installed by Rafaele Construction Corp.