

WATER SERVICE RECORD

Name Donald Wilson

Service No. 36

Address 36 Fern Street

Location

Repair—Renewal—New Service Eagle #686 ~~WOF 4964~~

MAR 18 '68


Date		Material	Amount	Total	Date	Amount
7-11-67	69'	3/4" Copper tubing			6-28-67	75.00
6-28-67		Labor 4.84			4-8-68	1.66
7-6-67		" 10.05	14.89			76.66
		10% O.H.	1.48	16.37		
	29'	3/4" Copper tubing @.79		22.91		
	1	3/4" Curb Cock		8.76		
	1	3/4" Corp Cock		7.42		
	1	Box & Rod		5.10		
	2	Ton Hot Top @5.80		11.60		
	1	hr. Trucking @3.00		3.00		
	1/2	hr. Roller @3.00		1.50		
				76.66		

DATE \_\_\_\_\_

# TOWN OF LEXINGTON — BOARD OF PUBLIC WORKS

## WATER DIVISION

Sketch of Service Here

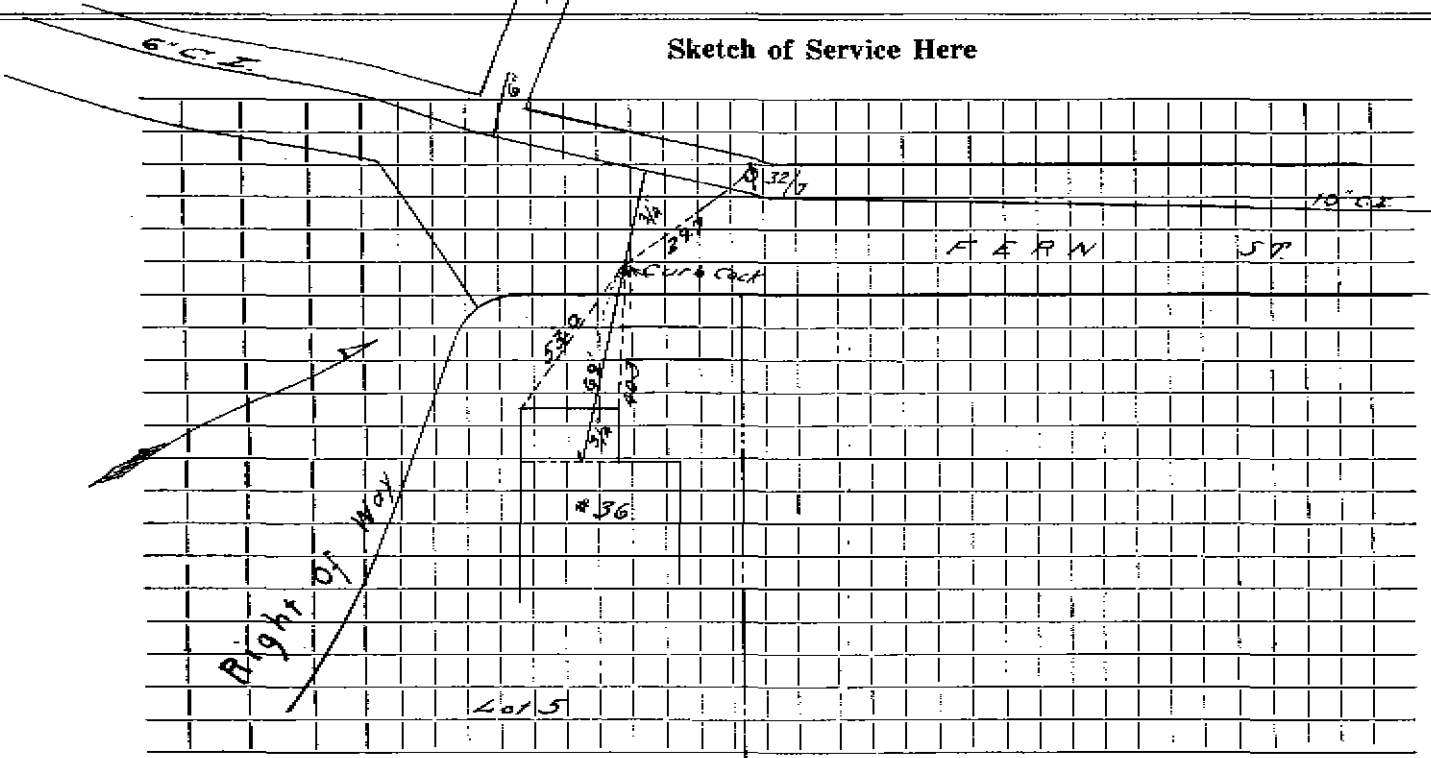

Connection made in \_\_\_\_\_ Street. Work completed \_\_\_\_\_

Remarks: \_\_\_\_\_  
\_\_\_\_\_  
\_\_\_\_\_