


DATE _____

TOWN OF LEXINGTON — BOARD OF PUBLIC WORKS

WATER DIVISION

Service for house # 46 Fern St.

Sketch of Service Here

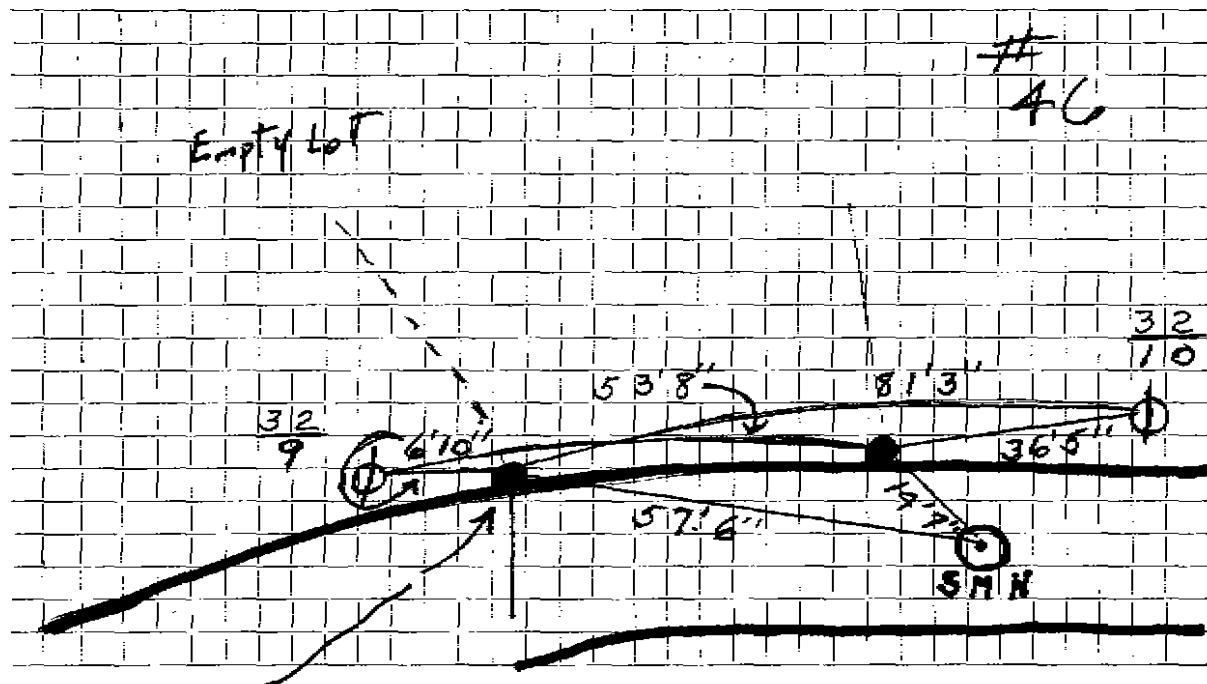

Connection made in Street. Work completed

Remarks: old service to no 40 shut off 9/97 ~~is to be cut~~ CUT AT CURB