

#6808

WATER SERVICE RECORD

Name Stanley Moore

Service No. 133 *NP*

Address 43 Fern Street

Location

~~REPAIR~~—Renewal—~~NEW SERVICE~~ W.O. #713 To 12" MAIN

MAR 14 1966


Date	Material	Amount	Total	Date	Amount
7/23/65	Labor	36 00		6-10-66	Paid
	10% O.H.	3 60	39 60		77 49
30'	3/4" copper tubing @.42		12 60	10/20/48	
1	3/4 x 1/2 W.H. Stop		9 29	5'	3/4 COPPER
1	Hr. Town Truck		3 00	1	3/4 Cuwb Cock
2	Hrs Tractor @6.50		13 00	1	3/4 CORP
			77 49		Box & Rod

DATE _____

TOWN OF LEXINGTON — BOARD OF PUBLIC WORKS

WATER DIVISION

Sketch of Service Here

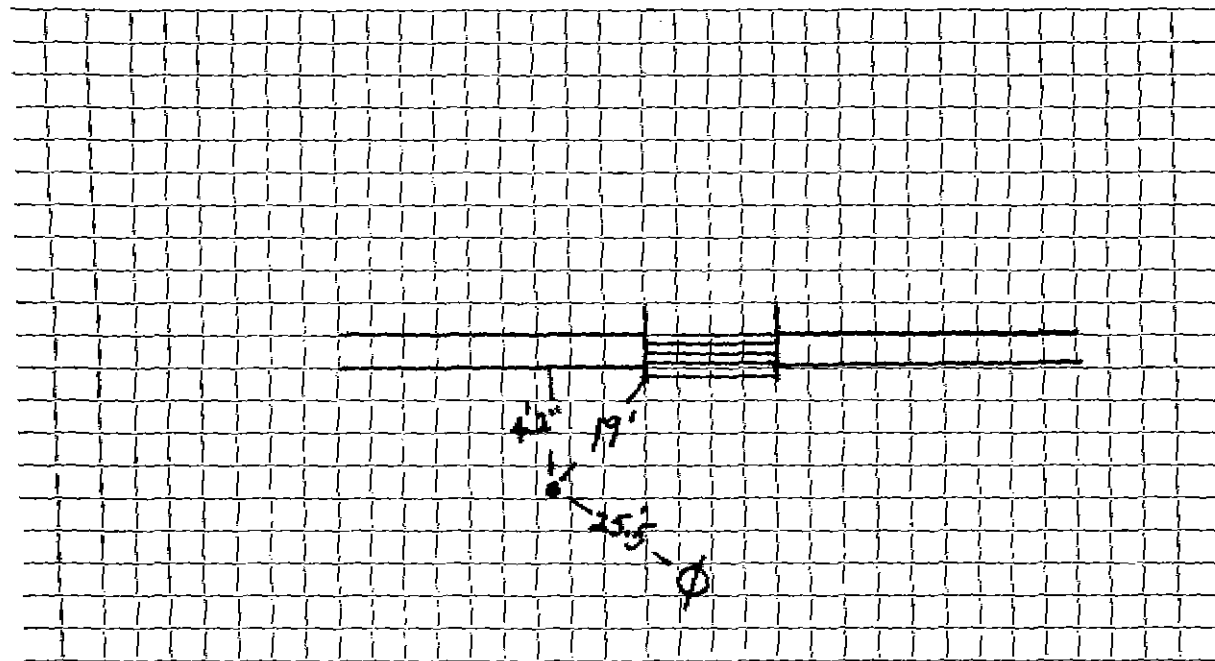

Connection made in Street. Work completed

Remarks:
.....
.....