

WATER SERVICE RECORD

Name J & G Enterprises

Service No.

Address 47 FERN ST

Location

Repair—Renewal—(New Service)

McLaughlin #4731

Date	Material	Amount	Total	Date	Amount
------	----------	--------	-------	------	--------

11/28/88 228' 6" of ~~1" Pipe~~
c/c & Box

10' 1" COPPER

1 1" COPP

1 1" Curb STOP


1 Box + Rod

DATE _____

TOWN OF LEXINGTON — BOARD OF PUBLIC WORKS

WATER DIVISION

Sketch of Service Here

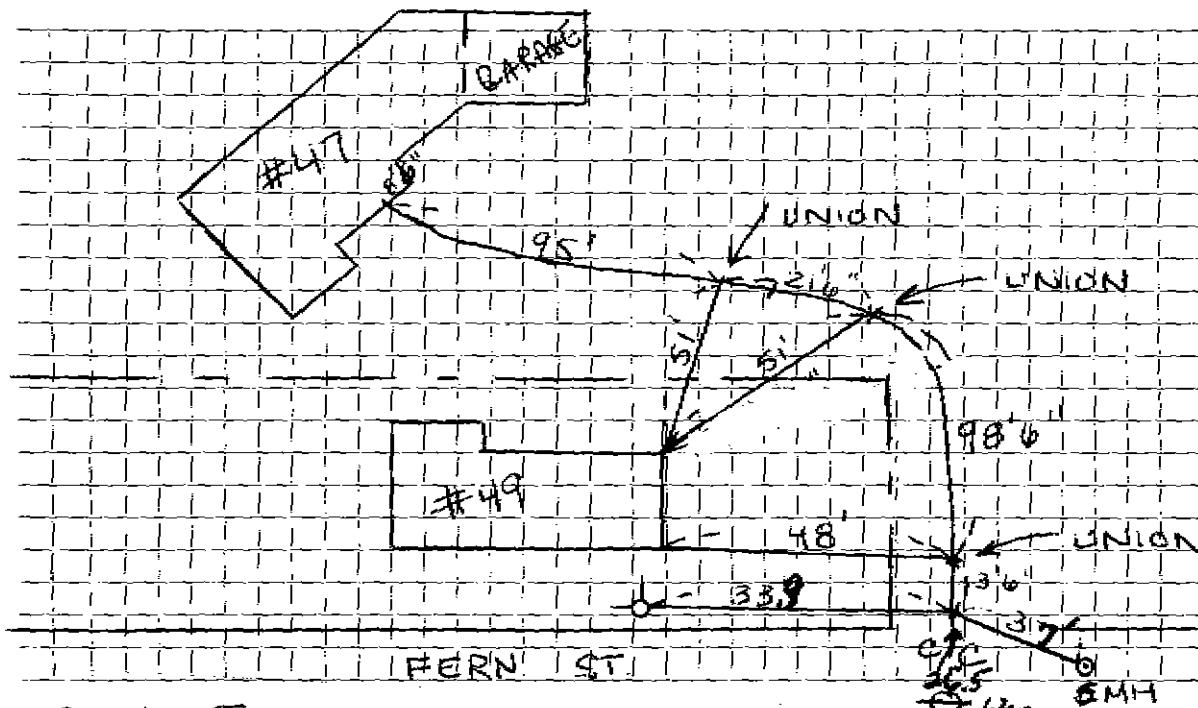

Connection made in FERN ST..... Street. Work completed 4/20.....

Remarks: NOTE....NO....OUTSIDE....TIES....2 Curb Boxes 6" APART - 1 for #85 Summit RD.....