

Name John A. Wilson

Service No.

Address 62 Fern Street

Lexington, Mass.

Location 62 Fern Street Changed to 1 John Wilson Rd

Kind of Pipe

Size

Size of Main

~~XXXXX~~ Renewal ~~XXXXXX~~ Renewed to main at Moreland Ave.

Location

Date	Material	Amount	Total	Date	Amount
	Service in off Rd about 10' <u>not in use,</u> beyond curb went to P.T.				
					Non-Charge
				Oct. 20, '18	Labor 1 25
					Main to Curb
				13' - 1"	Copper Tubing @.31 4 03
				15' - 1"	Copper Tubing @.31 4 65
				1 @ 1"	C Corp-cock 3 96
				1 - 1"	C x 1" C Curb-cock 4 80
				1 - 1"	C x 1" I Union (2pts) 1 74
				1 - 1"	Straight Tail Piece 30.
				1 -	Box & Rod 3 55
					24 28

Labor

DATE

TOWN OF LEXINGTON - BOARD OF PUBLIC WORKS

WATER DIVISION

The undersigned applies for a supply of water at No..... St. and hereby agrees to comply with the rules and regulations as now, or at any future time, established by the Board of Selectmen.

Am't of Estimate \$.....

Owner


Am't Paid \$.....

Address

Builder

.....

Sketch of Service Here

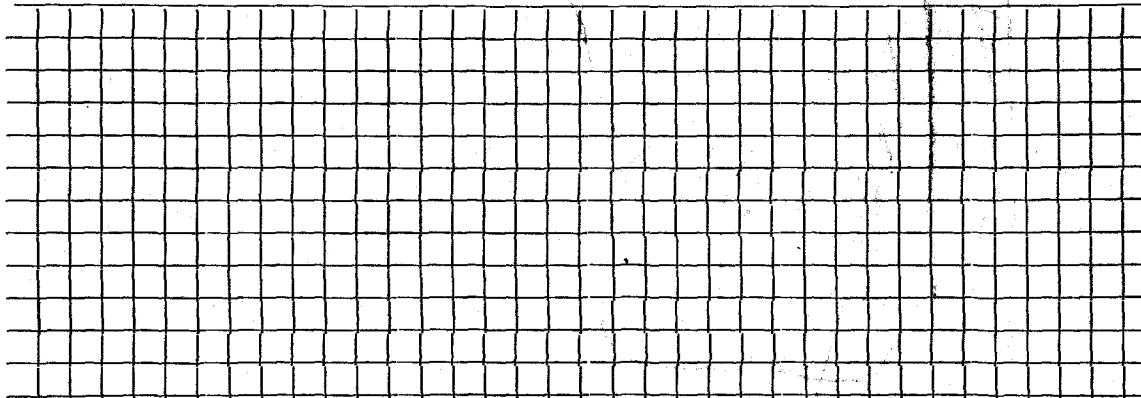

Connection made in Street.


Work completed19

Remarks:

TOWN OF LEXINGTON — BOARD OF PUBLIC WORKS

WATER DIVISION

Sketch of Service Here

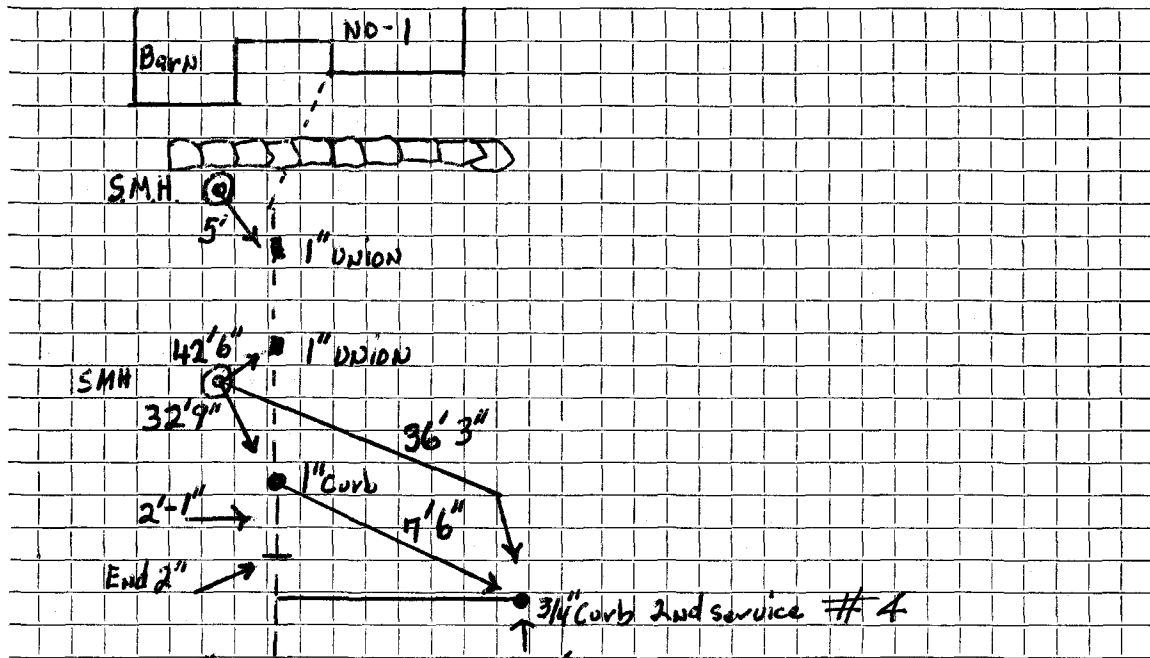

Connection made in Street. ↓ Work completed

Remarks: 1st 3/4" Service # 2

