

## WATER SERVICE RECORD

Name Philip B. Silva

Service No.

175

Address 7 Fern St., Lexington, Mass.

Location

~~Repair~~—Renewal—~~REPAIR~~ RENEW 12" MAIN


Comm. 10-28-57

Date	Material	Amount	Total	Date	Amount
9/5/57	Labor	35 93		8-12-57 Repair	100 00
9/6/57	Labor	17 85		10-28-57 Refund	3 45
		53 78			\$ 96 55
	10% overhead	5 38	59 16		Non Charge
20'-1" Copper tubing @ .5202		10 40		Labor	21 50
1-1" Cxl IWH Stop & Waste		5 60		8'-1" Copper tubing @.5202	4 16
1-3/4"x1" Bushing		64		1-1" C Corp Cock	5 94
1 hr. Trucking @ .75		75		1-1" C Curb Cock	4 64
20 x 3 Patch		20 00	37 39	1 Box & Rod	4 62
			96 55	1-3/4" Offset tail piece	50
				1-3/4" Straight tail piece	50
				1 hr. Trucking @.75	75
				8 x 3 Patch	8 00
				1 hr. Compressor @ 3.00	3 00
					53 61

DATE \_\_\_\_\_

**TOWN OF LEXINGTON — BOARD OF PUBLIC WORKS**  
**WATER DIVISION**

Sketch of Service Here

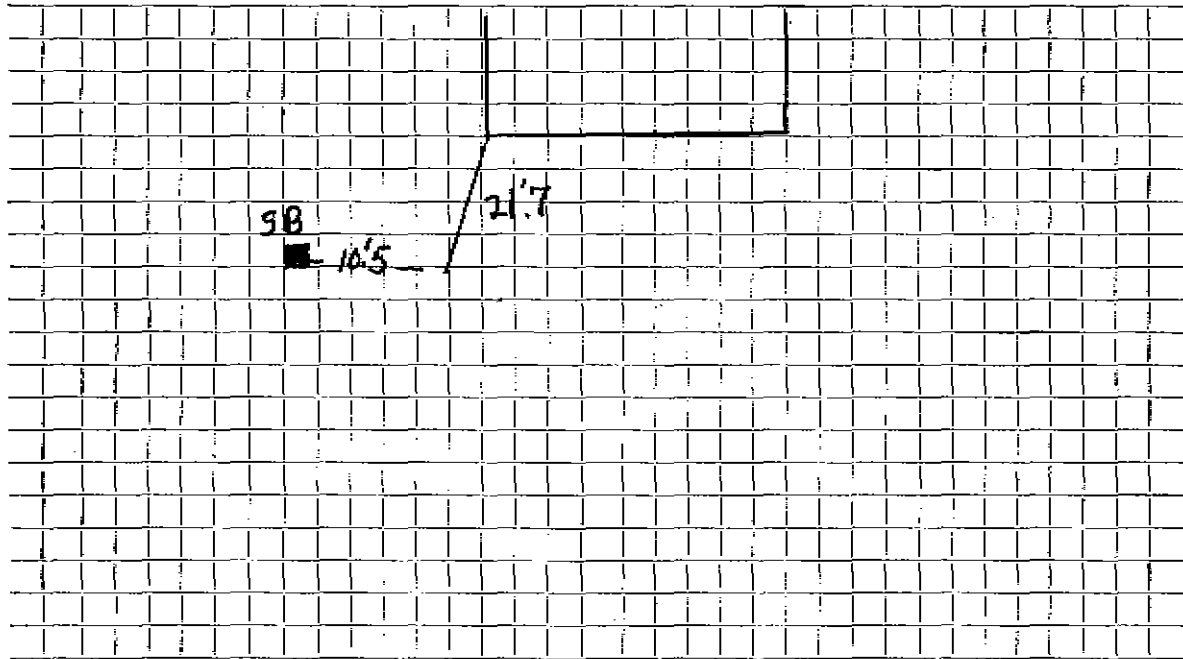

Connection made in ..... Street. Work completed .....

Remarks: .....  
.....  
.....