

Name, Amy Rogers

Service No. ~~88~~ 856

Address Fern Street

Location Same

Kind of Pipe

Size

Size of Main

~~Repair—Renewal—New Service~~

Location

Date

Material

Amount

Total

Date

Amount

9/14/36  
Comm. 15.00  
to Russell

7/7/36

Building pit and  
tapping main.....

\$15 00

July 2 1936  
" 10 1936

Deposited

11 00

4 00

15 00

Labor

DATE June 30, 1906

TOWN OF LEXINGTON—BOARD OF PUBLIC WORKS  
WATER DIVISION

The undersigned applies for a supply of water at No. \_\_\_\_\_ St. and hereby agrees to comply with the rules and regulations as now, or at any future time, established by the Board of Selectmen.

Am't. of Estimate \$ 11.00

Owner Amy Rogers 75 1/2 W. Longbottom


Am't. Paid \$ \_\_\_\_\_

Address Hess St

Builder \_\_\_\_\_

FIRST PIT ON RIGHT

Sketch of Service Here

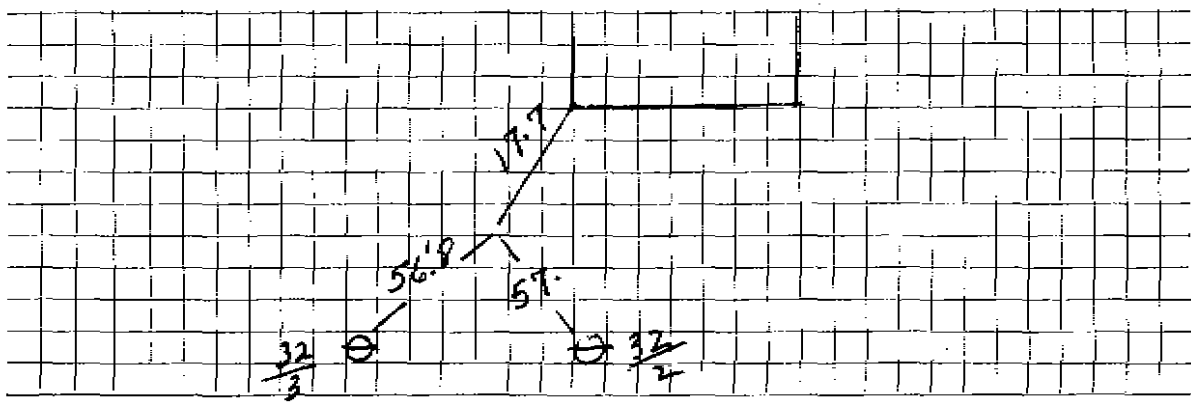

Connection made in \_\_\_\_\_ Street. Work completed \_\_\_\_\_ 19

Remarks: