

WATER SERVICE RECORD

Name

Service No.

Address *10 Fessenden Way*

Location

MAP 53 LOT 56


Repair—Renewal—New Service

Date		Material	Amount	Total	Date	Deflice	Amount
<i>9/2/60</i>	<i>86'</i>	<i>3/4" Copper</i>			<i>5/31/07</i>	<i>24.5</i>	
		<i>3/4" x 1/2" S & W</i>				<i>1</i>	
						<i>1</i>	
						<i>1</i>	
						<i>1</i>	
						<i>1" Copper</i>	
						<i>1" Corp</i>	
						<i>1" Curb Stop</i>	
						<i>1" x 3/4" Union</i>	
						<i>buffalo box</i>	

DATE _____

TOWN OF LEXINGTON — BOARD OF PUBLIC WORKS
WATER DIVISION

Sketch of Service Here

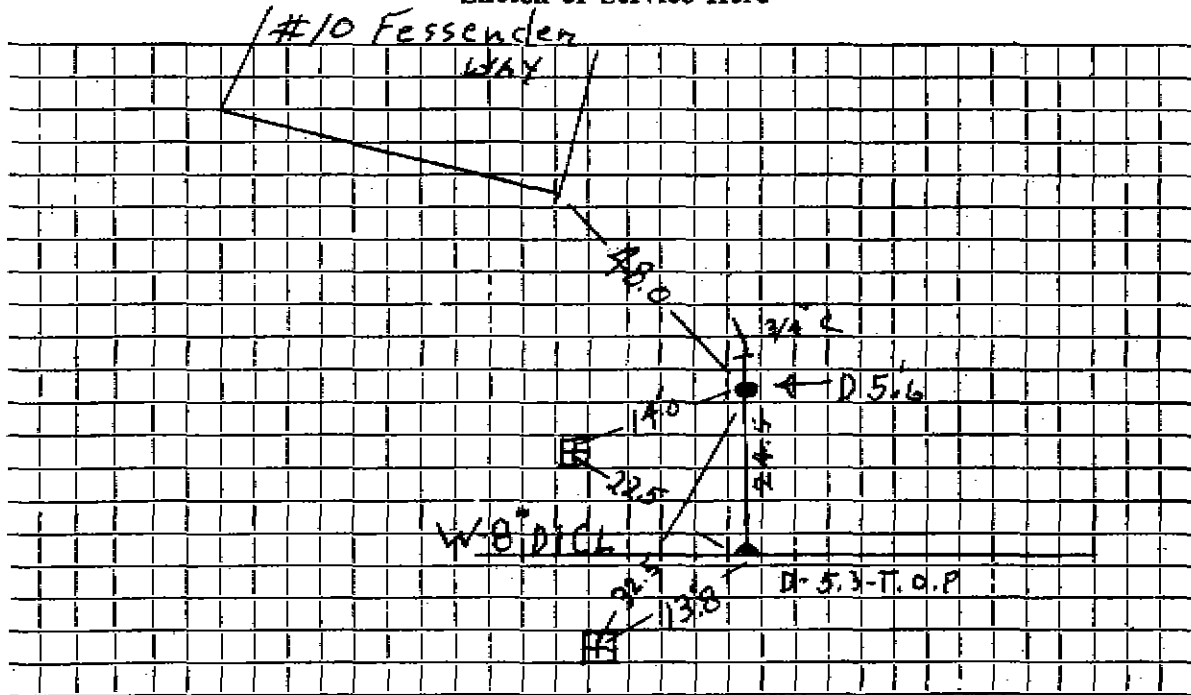

Connection made in Street. Work completed 5/31/07 Defluc

Remarks: 8" W-MAIN 2007