

WATER SERVICE RECORD

Name Benjamin Franklin Homes

Service No. 179

Address 12 Fessenden Way

Location

~~Repair - Renewal - New Service~~

Comm 11-17-60

Date	Material	Amount	Total	Date	Amount
8-31-60	Labor	20.88		8-31-60	50.00
	10% C.H.	2.09	22.97	11-28-60	14.79
72	3/4" Copper tubing @.42	30.24	30.24		64.79
1	3/4" G x 1/2" I.M.H. stop Waste	6.17			
1	Tr. Trucking @3.00	3.00	3.00	8-31-60	Labor
1	3/4" O 3 part union	2.41		12	3/4" Copper tubing @.42
			64.79	1	3/4" G Corp Cock
				1	3/4" G Curb Cock
				1	Box & Rod
				1	1/2" Straight Tailpiece
				1	1/2" Offset Tailpiece
					24.38

Deposit
Paid


NO CHARGE

DATE _____

TOWN OF LEXINGTON — BOARD OF PUBLIC WORKS

WATER DIVISION

Sketch of Service Here

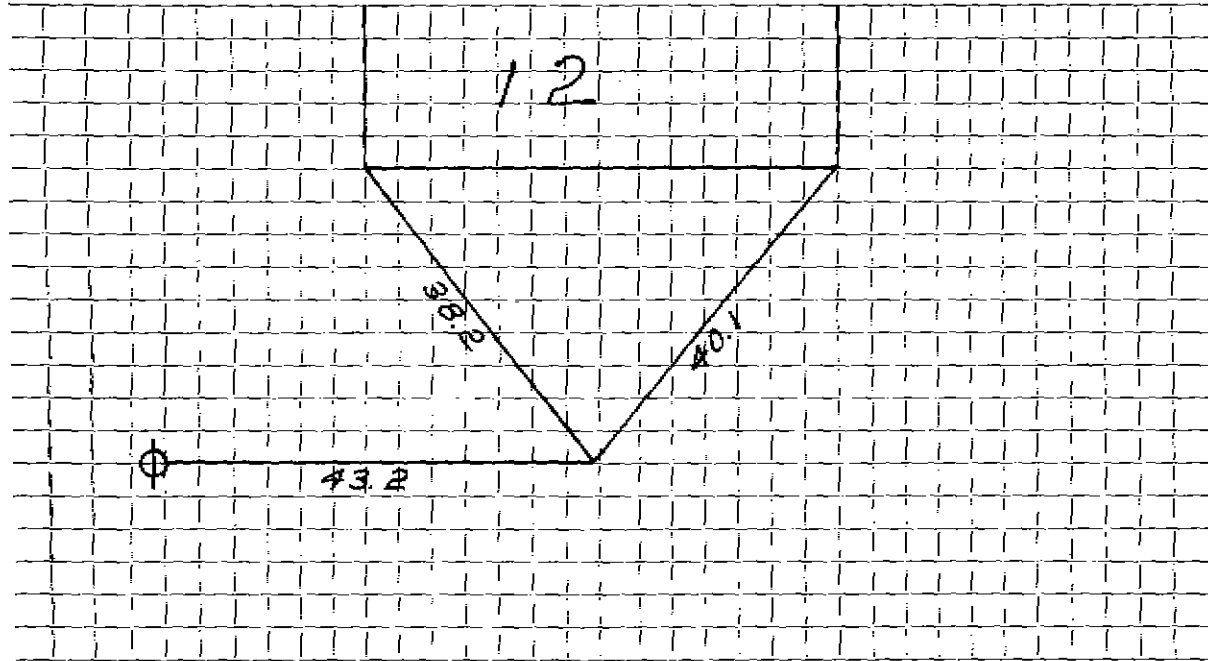

Connection made in Street. Work completed

Remarks:
.....
.....