

WATER SERVICE RECORD

Name site & Skelter

Service No. 233

Address 1 Field Road

2/20

Location Lexington, Mass.

~~Repair~~ ~~Renewal~~ New Service


Jan. 12 - 1951

Date	Material	Amount	Total	Date	Amount
11/5/51	Labor	1 65	1 65	9-25-51	Deposited 10 10
	0% overhead		17	9-23-52	Paid 55
	10' - 3/4" copper tubing @ .326	3 26			11 55
	1 - 3/4" Cx 1/2" I.W.H. stopwaste	4 00			<u>NON CHARGE</u>
	1 - 3/4" Cx 3/4" C. union (3pts.)	1 72	11/5/51	Labor	3 82
	1 hr. trucking		75	24' - 3/4" copper tubing @ .326	7 82
			11 55	1 - 3/4" C. corp-cock	4 33
	TRENCH DUG BY OWNER			1 - 3/4" C x 3/4" C. curb-cock	4 67
	PIPE SUPPLIER AND LAYD BY OWNER			1 box sand and rod	4 88
				1-1/2 offset tail piece	50
				1-1/2 straight tail piece	50
				1 hr. trucking	75
					27 17

DATE _____

TOWN OF LEXINGTON — BOARD OF PUBLIC WORKS
WATER DIVISION

Sketch of Service Here

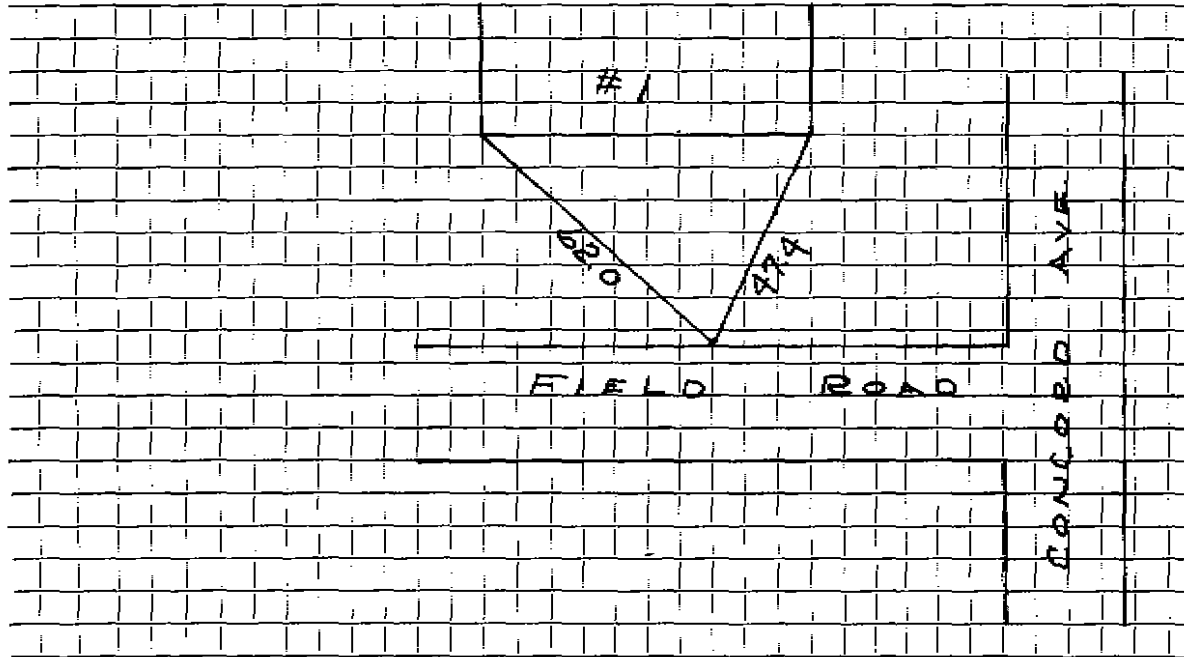

Connection made in Street. Work completed

Remarks:

.....