

WATER SERVICE RECORD

Name Site & Shelter

Service No. 300

Address 11 Field Road

526

Location Lexington, Mass.

Repair ~~Renewal~~ - New Service

Com. 11-3-51

Date	Material	Amount	Total	Date	Amount
10/31/51	Labor	1 65	1 65		
	10% overhead		17	9-23-52	
	10' - 3/4" copper tubing @ .326	3 26			
	1 - 3/4" Cx 3/4" I.W.H. stopwaste	4 00			NON CHARGE
	1 - 3/4" Cx 3/4" C. union (3pts.)	1 72	10/31/51	Labor	3 11
	1 hr. trucking		75		
			11 85	24' - 3/4" copper tubing @ .326	7 82
				1 - 3/4" C c orb-cock	4 23
	TRENCH DUG BY OWNER			1 - 3/4" C x 3/4" C. curb-cock	4 67
	PIPE SUPPLIED AND LAID BY OWNER			1 box and rod	4 68
				1 - 2" offset tail piece	50
				1 - 1/2" straight tail piece	50
				1 hr. trucking	75
					26 36


As Deposit Paid

11-3-51

DATE _____

TOWN OF LEXINGTON — BOARD OF PUBLIC WORKS
WATER DIVISION

Sketch of Service Here

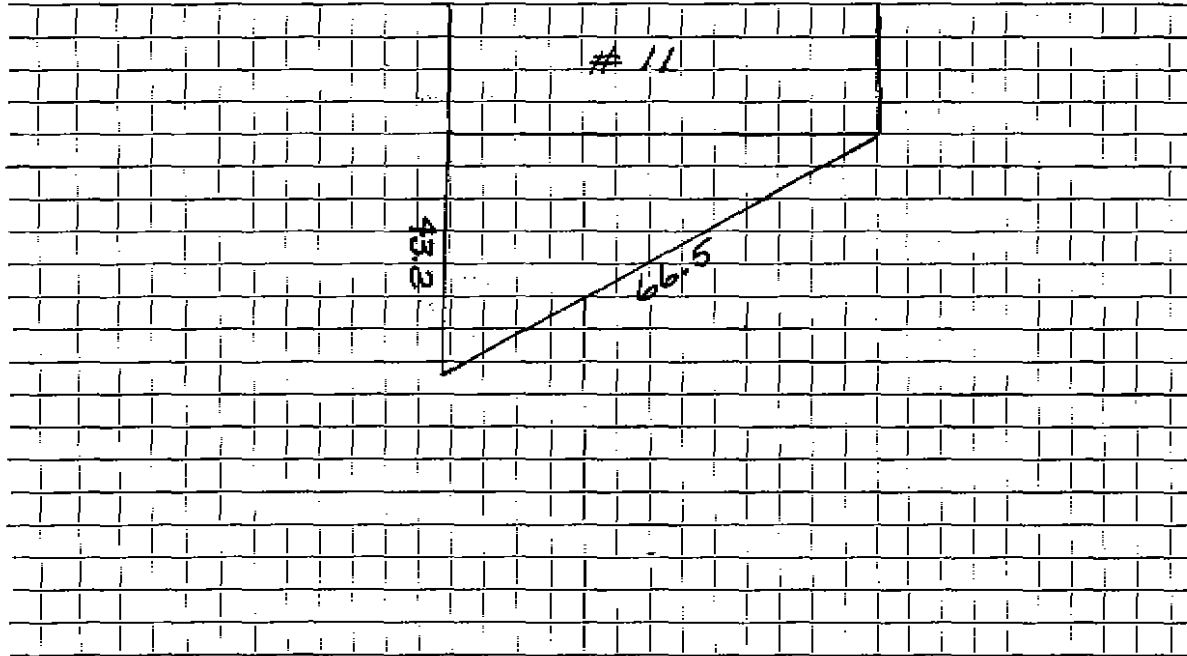

Connection made in Street. Work completed

Remarks:

.....
.....