

DATE _____

TOWN OF LEXINGTON—BOARD OF PUBLIC WORKS

WATER DIVISION

The undersigned applies for a supply of water at No. _____ St. and hereby agrees to comply with the rules and regulations as now, or at any future time, established by the Board of Selectmen.

Am't. of Estimate \$ _____

Owner _____


Am't. Paid \$ _____

Address _____

Builder _____

12-1-93 House to be torn down

Sketch of Service Here

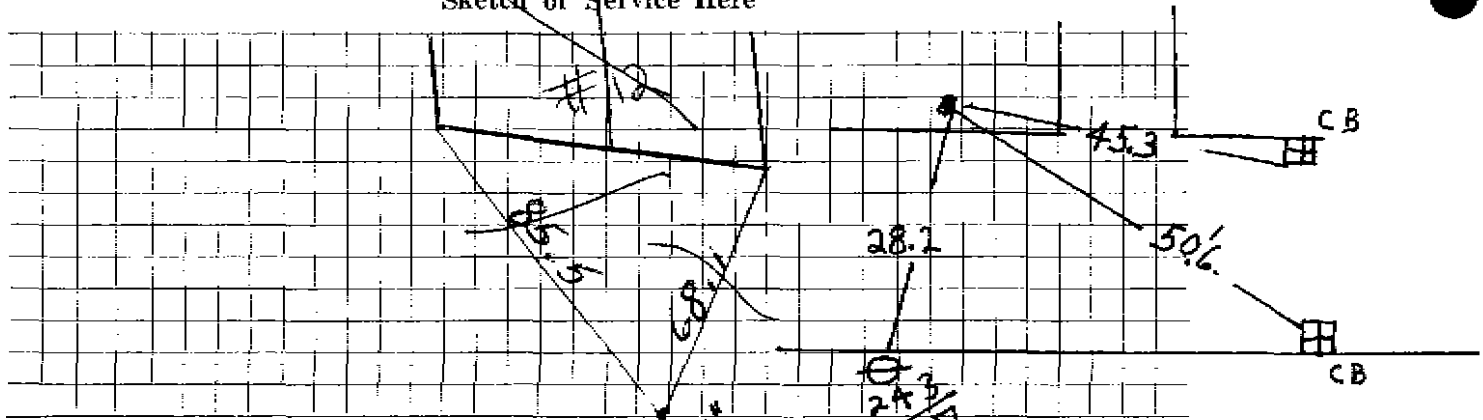

Connection made in _____

Street *28.6*

Work completed _____

19

Remarks:

243/7