

Name Site & Shelter, Inc.

Service No. 235

Address 15 Field Road

#7497

Lexington

Locatic

Kind of Pipe

Size

Size of Main

~~15 Field Road~~—New Service

15-3-51

Location

Date	Material	Amount	Total	Date	Amount
11/1/51	Labor	1 85	1 85	9-25-51	10 00
	10% overhead		17	9-23-52	2 20
	12' -3/4" copper tubing @ .326	3 91			12 20
	1 -3/4" C x 1/2 I.W.H. stop W.	4 00			
	1 -3/4" C x 3/4" C. union (3pts.)	1 72		11/1/51	2 65
	1 hr. trucking		75	24' -3/4" copper tubing @ .326	7 82
	trench dug by owner		12 20	1 - 3/4" C. corp-cock	4 33
	pipe supplied & laid by owner			1 - 3/4" C x 3/4" C. curb-cock	4 67
				1 box sand rod	4 68
				1 1/2 offset tail piece	50
				1 - 1/2 straight tail piece	50
				1 hr. trucking	75
					23 90
	Labor				
			LEAK	11/16/76	13' 3/4 COPPER
					1 3/4 CORR

Hudley Press, Inc., Lexington

DATE _____

TOWN OF LEXINGTON—BOARD OF PUBLIC WORKS

WATER DIVISION

The undersigned applies for a supply of water at No. _____ St. and hereby agrees to comply with the rules and regulations as now, or at any future time, established by the Board of Selectmen.

Am't. of Estimate \$ _____


Owner _____

Am't. Paid \$ _____

Address _____

Builder _____

Sketch of Service Here

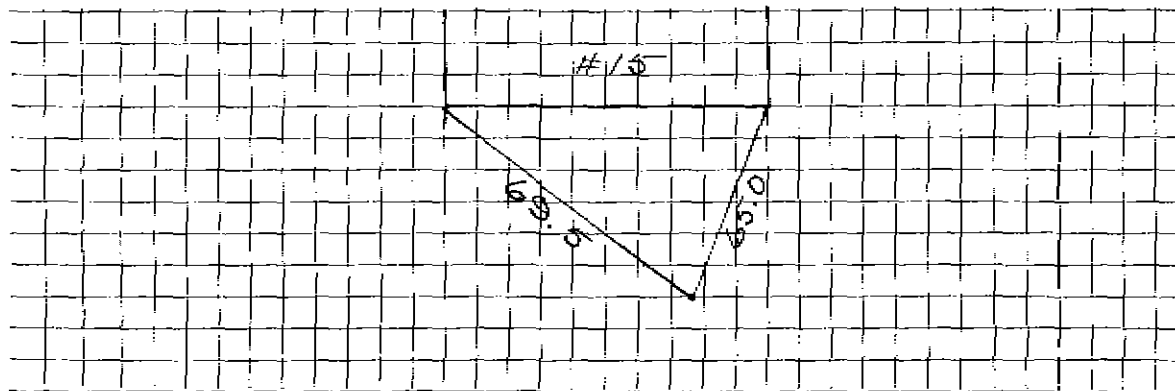

Connection made in _____ Street.

Work completed _____ 19


Remarks:

DATE _____

TOWN OF LEXINGTON — BOARD OF PUBLIC WORKS

WATER DIVISION

Sketch of Service Here

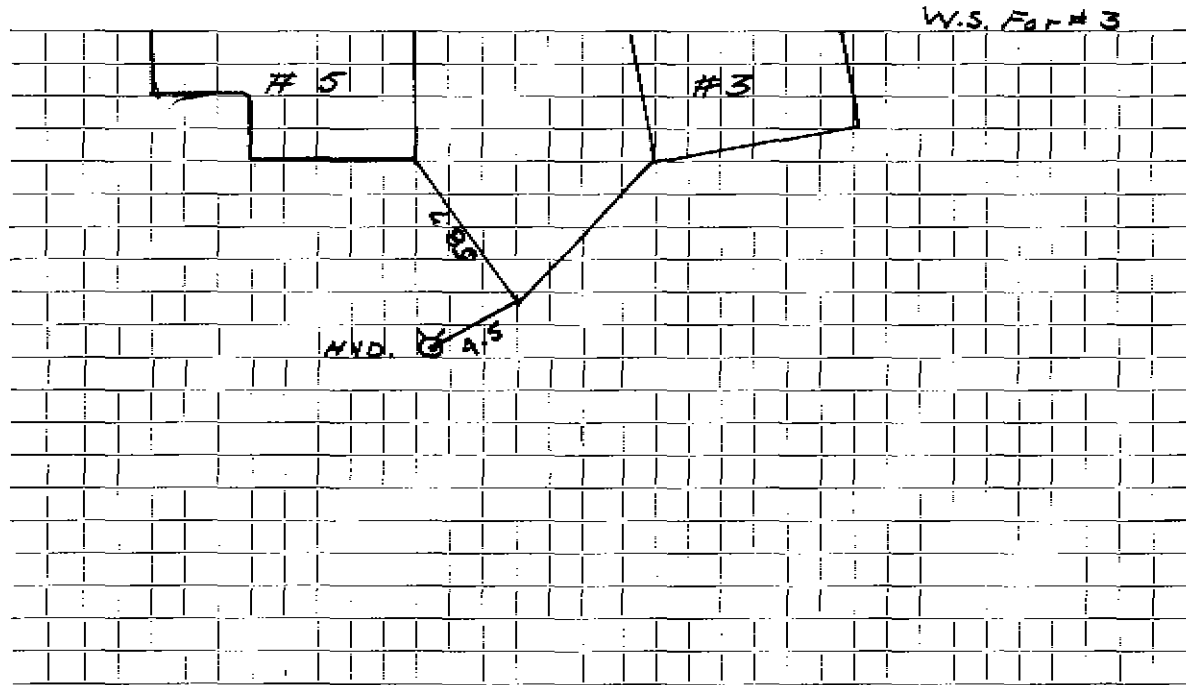

Connection made in Street. Work completed

Remarks:
.....
.....