

WATER SERVICE RECORD

Name Randall & MacDonald

Service No. 114

Address 4 Field Road

Location

Repair—Renewal—New Service

Comm. 11-19-56


| Date | Material | Amount | Total | Date | Amount |
|--------|-----------------------------------|--------|-------|----------|------------------------------|
| 6/4/56 | Labor | 13 57 | | 5-22-56 | Deposit 150 00 |
| | 10% overhead | 1 36 | 14 93 | 11-19-56 | Refund 55 20 |
| | 1 1/2" 3/4" copper tubing @ .4850 | 68 87 | | | <u>NON CHARGES</u> 94 80 |
| | 1 3/4" C x 1/2" I.W.H. stop&waste | 4 96 | | | Labor 1 90 |
| | 2 hrs. trucking @ .75 | 1 50 | | | 1 1/2 Straight tail piece 50 |
| | 2 3/4" C Unions 3 Piece | 4 54 | | | 1 1/2 Offset Tail Piece 50 |
| | | | 94 80 | | <u>2 90</u> |
| | | | | 10/30/51 | |
| | | | | | 10' 3/4 COPPER |
| | | | | | 1 3/4 CORP |
| | | | | | 1 3/4 C curb Cock |

DATE _____

TOWN OF LEXINGTON — BOARD OF PUBLIC WORKS

WATER DIVISION

Sketch of Service Here

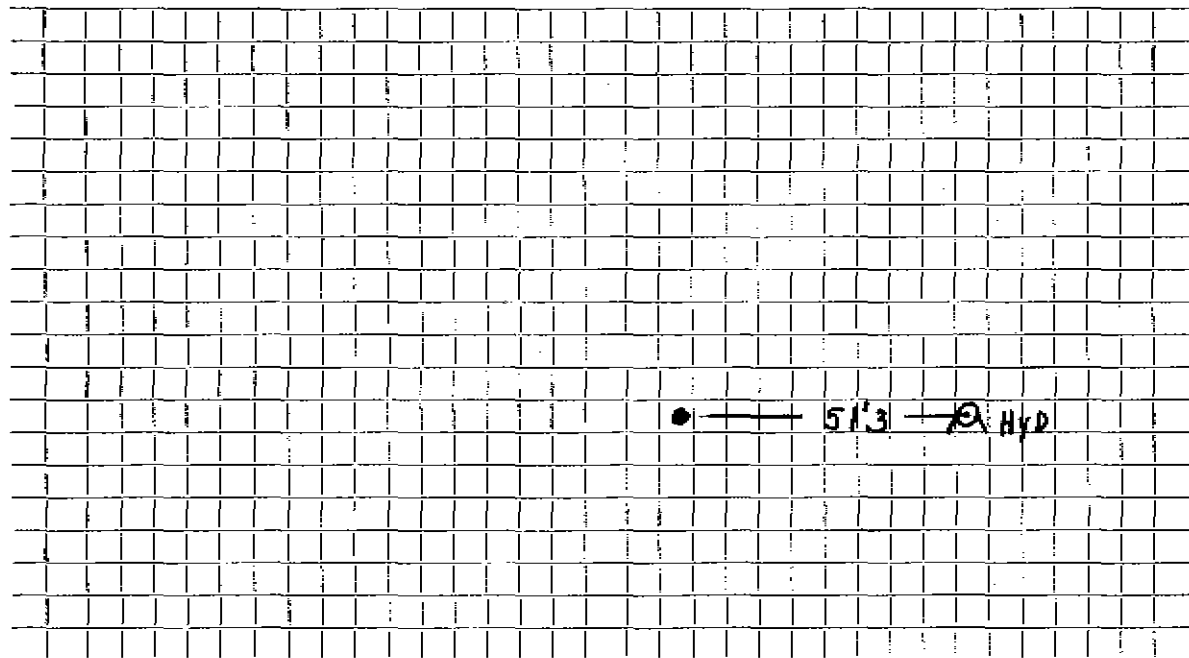

Connection made in Street. Work completed

Remarks:

.....

.....