

WATER SERVICE RECORD

Name Moore Construction Company, Inc.

Service No. 109

Address 5 Field Road

Location

~~Repair & Renewal~~ - New Service

Comm. 9-3-57

Date	Material	Amount	Total	Date	Amount
6/12/57	Labor	38 24		5-28-57	Deposit \$ 100 00
	10% overhead	3 82	42 06	9-10-57	Paid 23 35
	77' - 3/4" Copper tubing @ .4228	.4228	32 56		<u>NON CHARGE</u> # 123 35
	1 - 3/4" Cx 1/2 I.W.H. Stop & Waste		4 96	Labor	11 42
	1 - 3/4" C. Union (3 part)		2 27	24' - 3/4" Copper tubing @ .4228	10 15
	21x3 Patch		21 00	1 - 3/4" C. Corp Cock	4 64
	2 hrs. Town Shovel @ 6.50		13 00	1 - 3/4" C. Curb Cock	5 94
	2 hrs. Trucking @ .75		1 50	1 Box & Rod	4 62
	1 hr. Trucking		3 00	1 - 1/2 Straight tailpiece	50
	1 hr. Rodgers Trailer		3 00	1 - 1/2 Offset tailpiece	50
			123 35	1 hr. Town Shovel @ 6.50	6 50
				1 hr. Trucking	75
					<u>45 02</u>


Bill sent 9-5-57

DATE _____

TOWN OF LEXINGTON — BOARD OF PUBLIC WORKS

WATER DIVISION

Sketch of Service Here

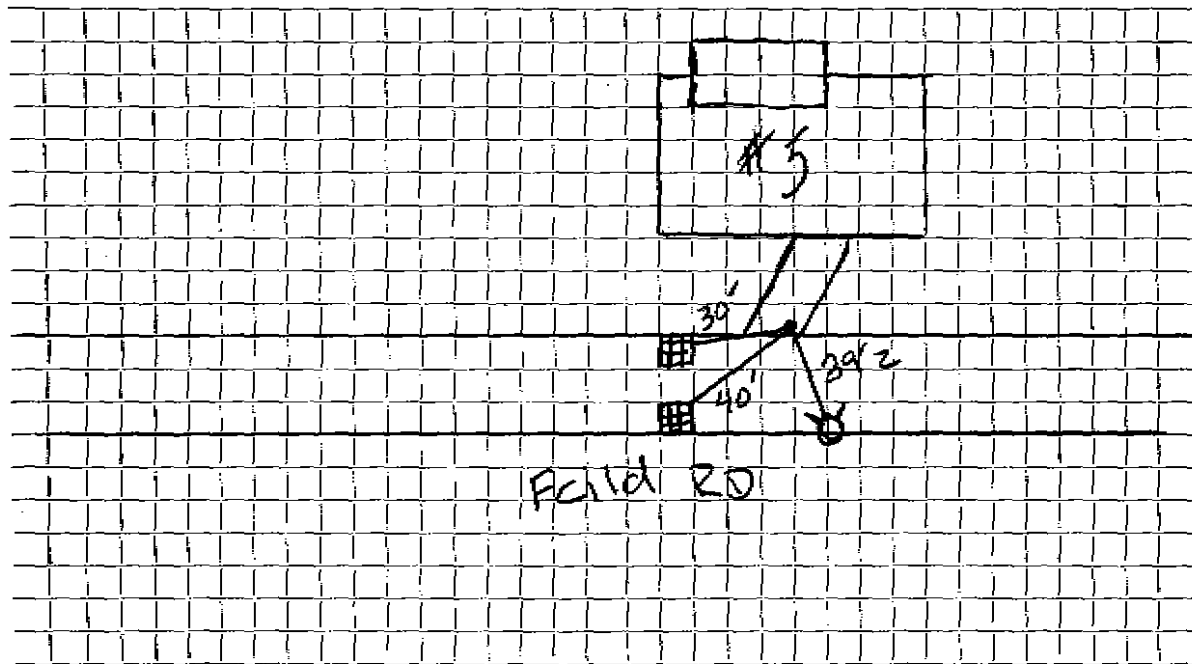

Connection made in _____ Street. Work completed _____

Remarks: _____
