

Name Site & Shelter

Service No. 233

Address 6 Field Road

894

Location

Kind of Pipe

Size

Size of Main

~~Repair - Renewal~~ New Service

Com. 14-0-51

Location

Date	Material	Amount	Total	Date	Amount
------	----------	--------	-------	------	--------


10-30-51	Labor	1 65	1 65	7-25-51	Deposited	10 00
	10% Overhead		17	12-3-51	Refund had credited	(3 43)
	1-3/4" Cx 1/2 I.W.H. S&W		4 00		to bal. due on # 206	6 57
	1 Hr. Trucking		75		No Charge	

6 57	10-30-51	Labor	2 02
		10'-3/4" Copper Tubing @.326	3 26
		1-3/4" C Corp Cock	4 33
		1-3/4" Cx 3/4" Curb Cock	4 67
		1-Box & Rod	4 68
		1 *1/2 Offset Tail Piece	50
		1-1/2 Straight Tail Piece	50
		1 Hr. Trucking	75
		Total	20 71

Labor

Trench Dug By Owner
Pipe Supplied And Laid By Owner

The Bailey Press, Boston

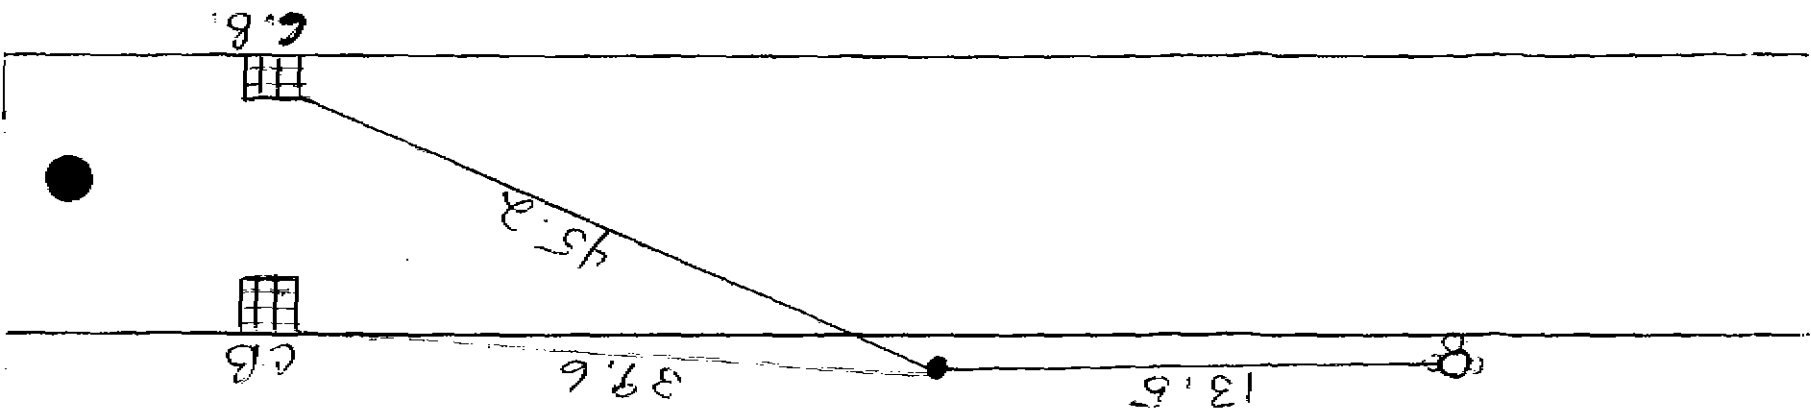

#6