

Name Site & Shelter, Inc.

Service No. 233

Address 8 Field Road

#7309

Lexington

Locatic

Kind of Pipe

Size

Size of Main

~~Repair~~ - Renewal - New Service

Com. 12 3-51

Location

Date	Material	Amount	Total	Date	Amount
10/30/51	Labor	1 65	1 65	9-25-51	10 00
	10% overhead		17	9-23-52	4 48
	19' -3/4" copper tubing @ .526	6 19			14 48
	1 -3/4" C x 1/2" I.W.H. Stop & L.	4 00		10/30/51	2 02
	1 -5/4" C x 3/4" C. union (3pts.)	1 72		13' -3/4" copper tubing @ .526	4 28
	1 hr. trucking		75	1 - 3/4" C. curb-cock	4 33
			14 48	1 -3/4" C x 3/4" C. curb-cock	4 67
	Trench dug by owner			1 box and rod	4 68
	pipe supplied and laid by owner			1 -1/2" offset tail piece	50
				1 -1/2" straight tail piece	50
				1 hr. trucking	75
	Labor				21

Deposited
Paid
NON CHARGE

12-3-51

Hadley Press, Inc., Lexington

DATE _____

TOWN OF LEXINGTON—BOARD OF PUBLIC WORKS
WATER DIVISION

The undersigned applies for a supply of water at No. _____ St. and hereby agrees to comply with the rules and regulations as now, or at any future time, established by the Board of Selectmen.

Am't. of Estimate \$ _____


Owner _____

Am't. Paid \$ _____

Address _____

Builder _____

Sketch of Service Here

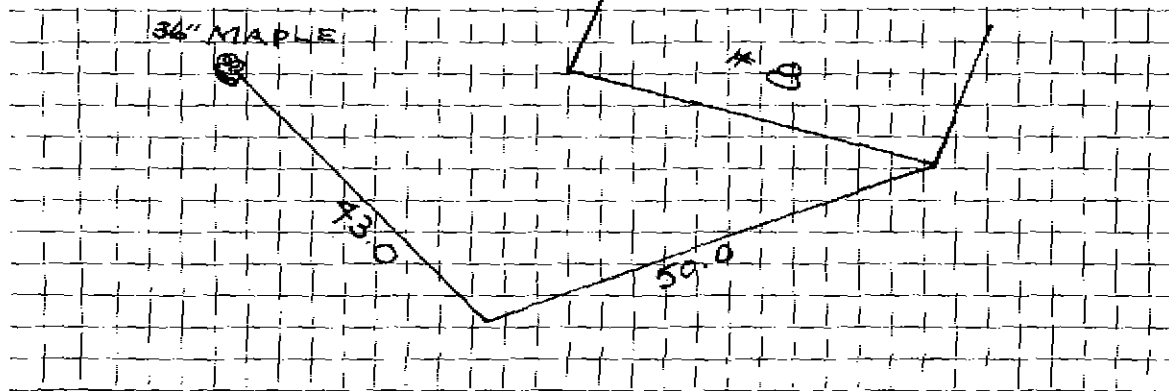

made in _____ Street.

Work completed _____ 19