


TOWN OF LEXINGTON — BOARD OF PUBLIC WORKS
WATER DIVISION

Sketch of Service Here

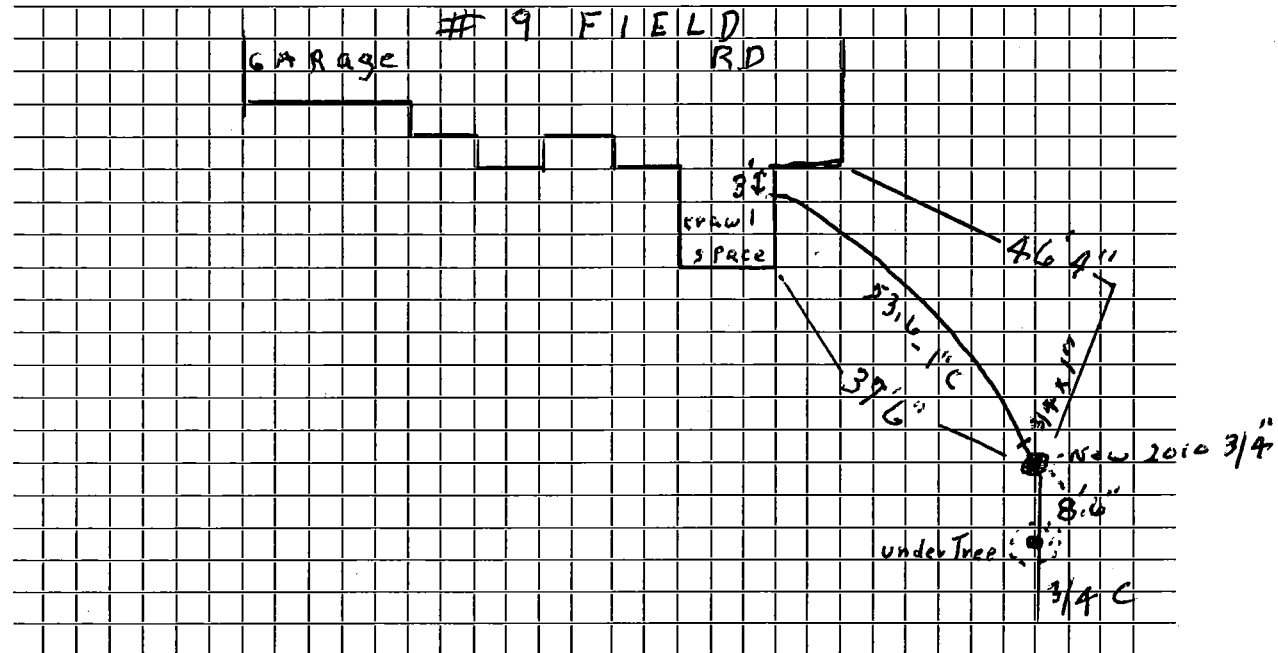

Connection made in Street. Work completed 10/15/10 J. McLaughlin.
Remarks: Old 3/4 Curb left Under Tree
.....
.....