


DATE _____

TOWN OF LEXINGTON — BOARD OF PUBLIC WORKS
WATER DIVISION

Sketch of Service Here

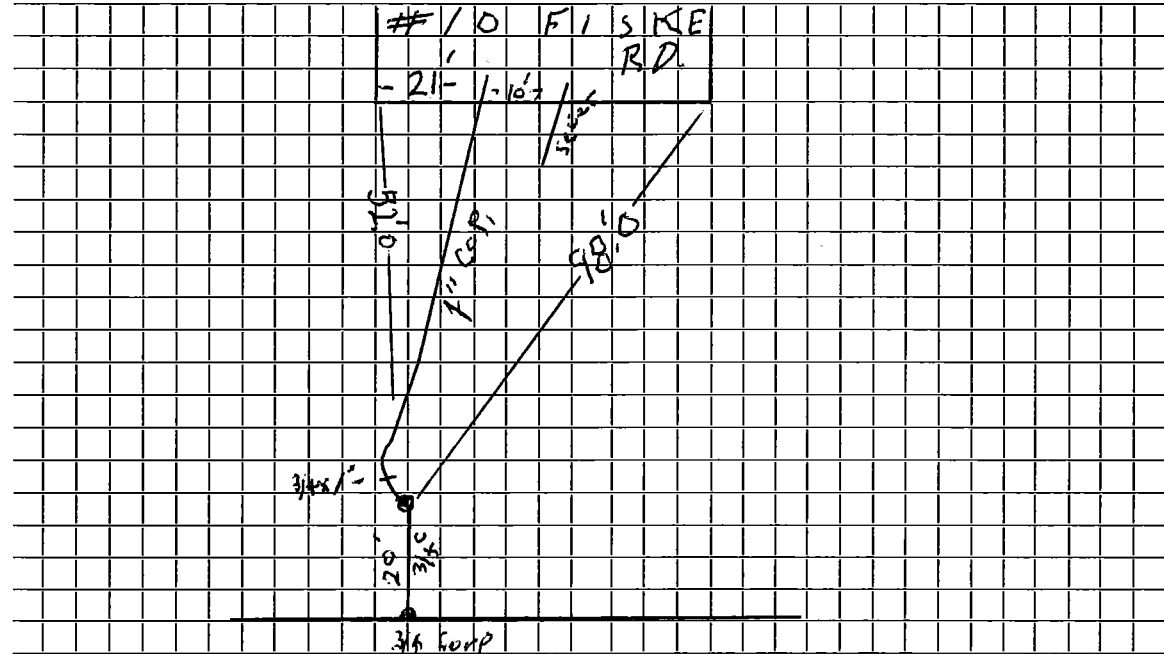

Connection made in Street. Work completed 10/2010
Remarks: EXIST 3/4\" W - In. ST, W + S - 10' Apart
.....
.....