

WATER SERVICE RECORD

Name DeVries Const. Company

Service No. 167

Address 11 Fiske Road

Location

Repair ~~Renewal~~ - New Service


*Com. 8-15-55*

Date	Material	Amount	Total	Date	Amount	
5/26/55	Labor	1 85		6-6-55	35 00	
	10% Overhead	19	2 04	8-15-55	4 16	
	33' - 3/4" Copper tubing	3.3693	30 68		39 16	
	1 - 3/4" C.I. W.F. str & waste		4 00	5/26/55	Labor	5 05
	1 - 3/4" C x 3/4" Union 3 pts.		1 72	10' - 3/4" Copper tubing	3 60	
	1 hr. trucking		75	1 - 3/4" comp. sock	4 33	
			39 16	1 - 3/4" C x 3/4" union sock	4 67	
TRENCH DIG BY OWNER				1 box sand pad	3 00	
				1 - 1/2 offset tail piece	50	
				1 - 1/2 straight tail piece	50	
				1 hr. trucking	75	
					23 39	

DATE \_\_\_\_\_

TOWN OF LEXINGTON — BOARD OF PUBLIC WORKS  
**WATER DIVISION**

Sketch of Service Here

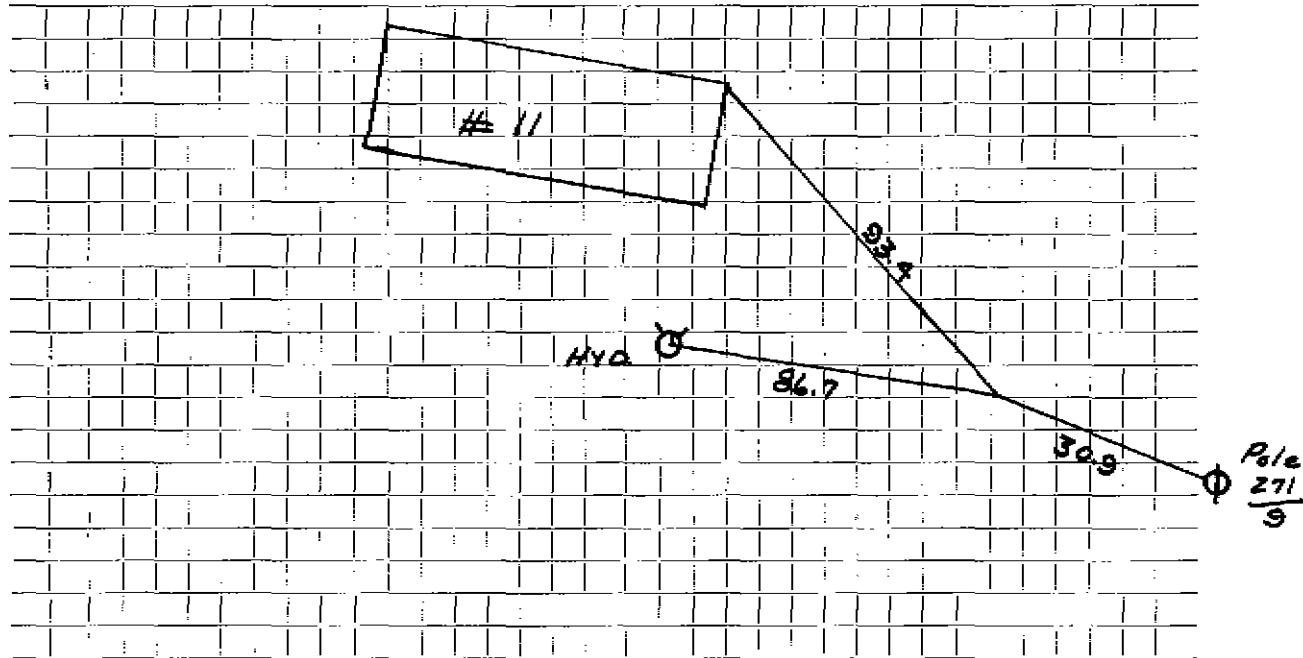

Connection made in ..... Street. Work completed .....

Remarks: .....

.....

.....