


Water Service Tie Card  
**TOWN OF LEXINGTON**  
 MASSACHUSETTS

**12 Fiske Rd**

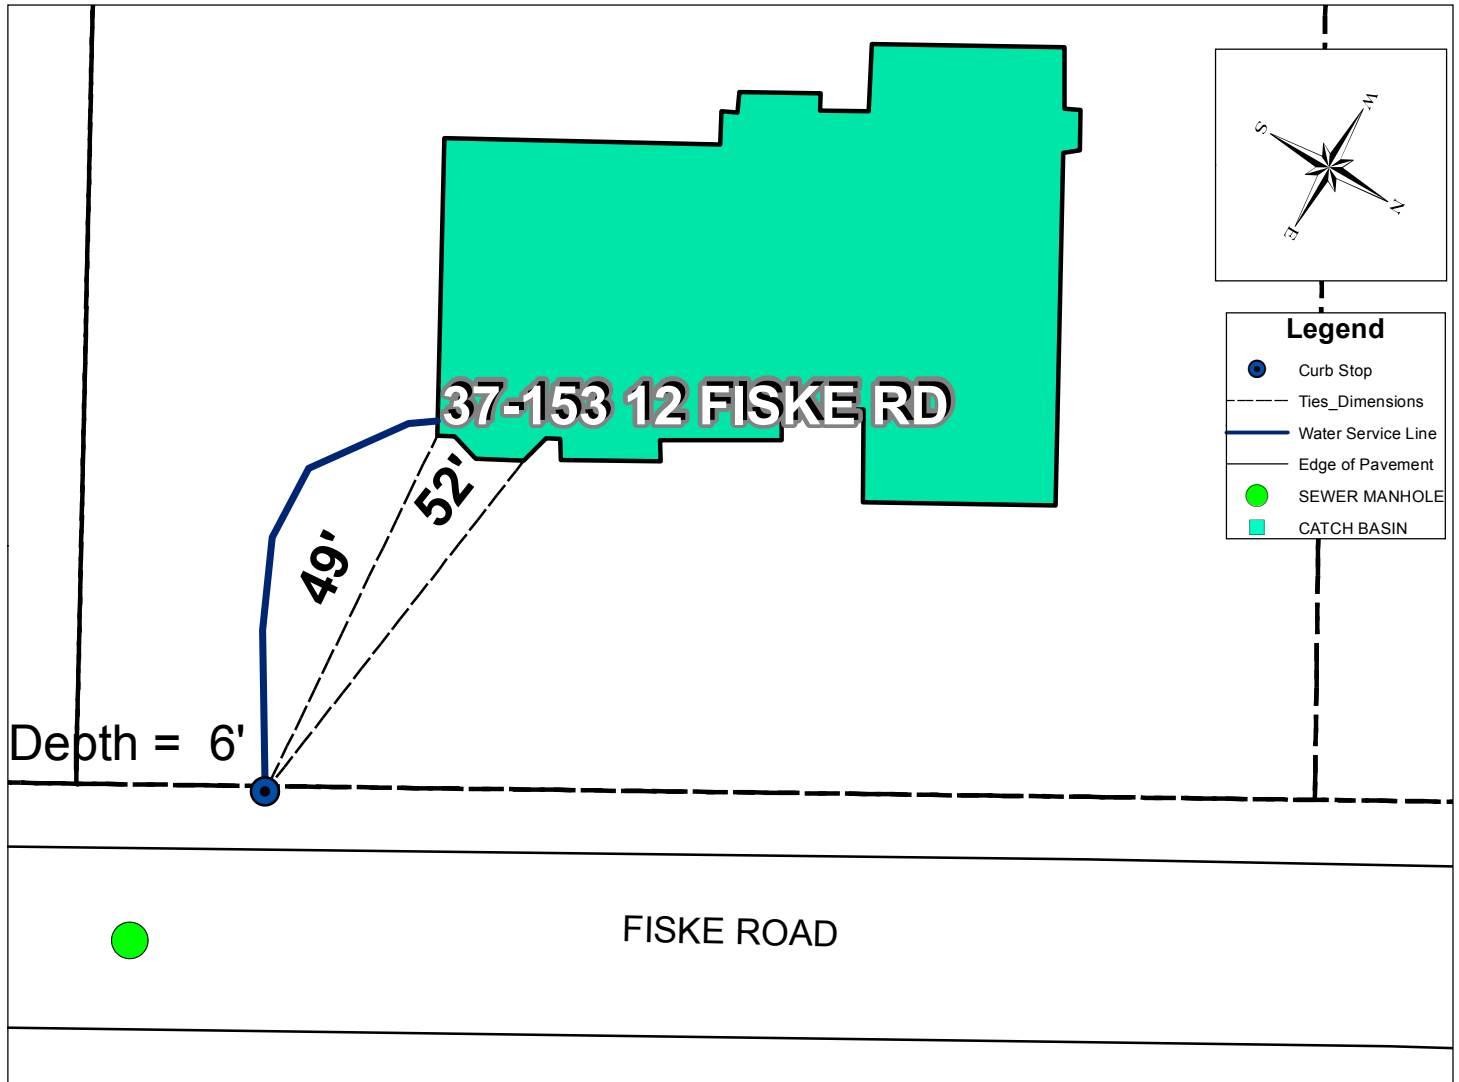

Address	Map and Lot	Permit Number	Contractor Name	Inspector
12 Fiske Rd	37-153		Kiely Excavation	msprague
Date	Material	Depth of Cover	Amount	
4/14/2015	3/4" Copper type "k"	6 ft	6"	
	3/4" to 1" fitting	6 ft	1	
	1" Copper type "k"	6 ft	1	
	1" Curb Valve and Buffalo Box	6 ft	60 ft to HSE	
Type of work completed				

New 1" water service to house from curb stop. New house on lot old house removed.