

DeVries Const. Company WATER SERVICE RECORD

Service No. 185

Name

Address 15 Fiske Road

Location

Repair—Renewal—New Service

Comm. 8-15-55


Date	Material	Amount	Total	Date	Amount
6/7/55	Labor	1 85		6-6-55	Deposited 225 00
	10% Overhead	19	2 04	8-15-55	Paid (7 85
	93' - 3/4" Copper tubing	50.3693	54 34		NON CHARGE 42 85
	1 - 3/4" C x 1/2" I/W.H. stopcock	4 00		6/7/55	Labor 5 27
	1 - 3/4" C x 3/4" C. Union 3 pts.	1 72			27' - 3/4" Copper tubing 9 97
	1 hr. trucking		75		1 - 3/4" C. corp-cock 4 32
			42 85		1 - 3/4" C x 3/4" C. curb-cock 4 27
TRENCH DIG. BY OWNER					1 box and rod 3 90
					1 - 1/2" offset tail piece 50
					1 - 1/2" straight tail piece 50
					1 hr. trucking 75
					29 89

DATE _____

TOWN OF LEXINGTON — BOARD OF PUBLIC WORKS

WATER DIVISION

Sketch of Service Here

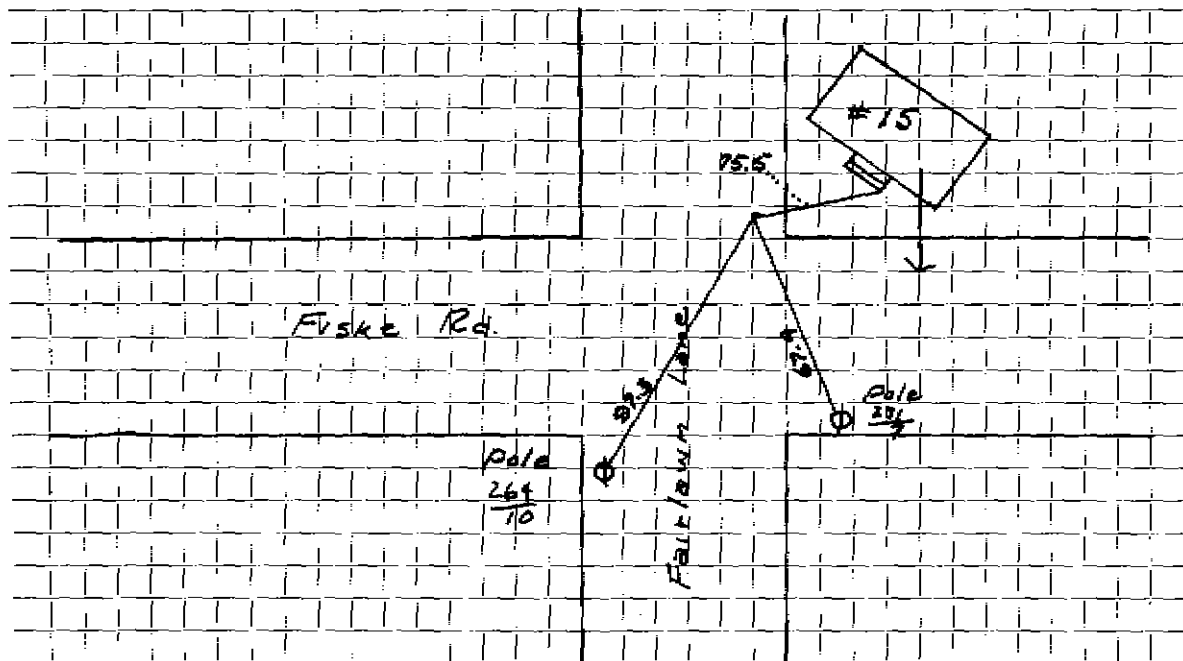

Connection made in Street. Work completed

Remarks:

.....

.....