

WATER SERVICE RECORD

Name DeVries Const. Company

Service No. 211

Address 17 Fiske Road

3691

Location

Repair—Renewal—New Service

Com. 8-15-55

Date	Material	Amount	Total	Date	Amount
8/7/55	Labor	1 25			
	10% Overhead	19	2 04	8-15-55	39 90
	85' - 3/4" Copper tubing @ 36¢	31 30			
	1 - 3/4" Cx 1/2" W.H. stop paste	4 00		8/7/55	Labor 5 27
	1 - 3/4" Cx 3/4" C. Union 3 pts.	1 72			10' - 3/4" Copper tubing @ 36¢ 3 69
	1 hr. trucking		75		1 - 3/4" C. curb-cock 4 33
			39 75		1 - 3/4" Cx 3/4" C. curb-cock 4 67
	TRENCH DUG BY OWNER				1 box and rod 3 90
					1 - 1/2" offset tail piece 50
					1 - 1/2" straight tail piece 50
					1 hr. trucking 75
					<u>23 61</u>

No Deposit

Paid


NO CHANGE

DATE _____

TOWN OF LEXINGTON — BOARD OF PUBLIC WORKS

WATER DIVISION

Sketch of Service Here

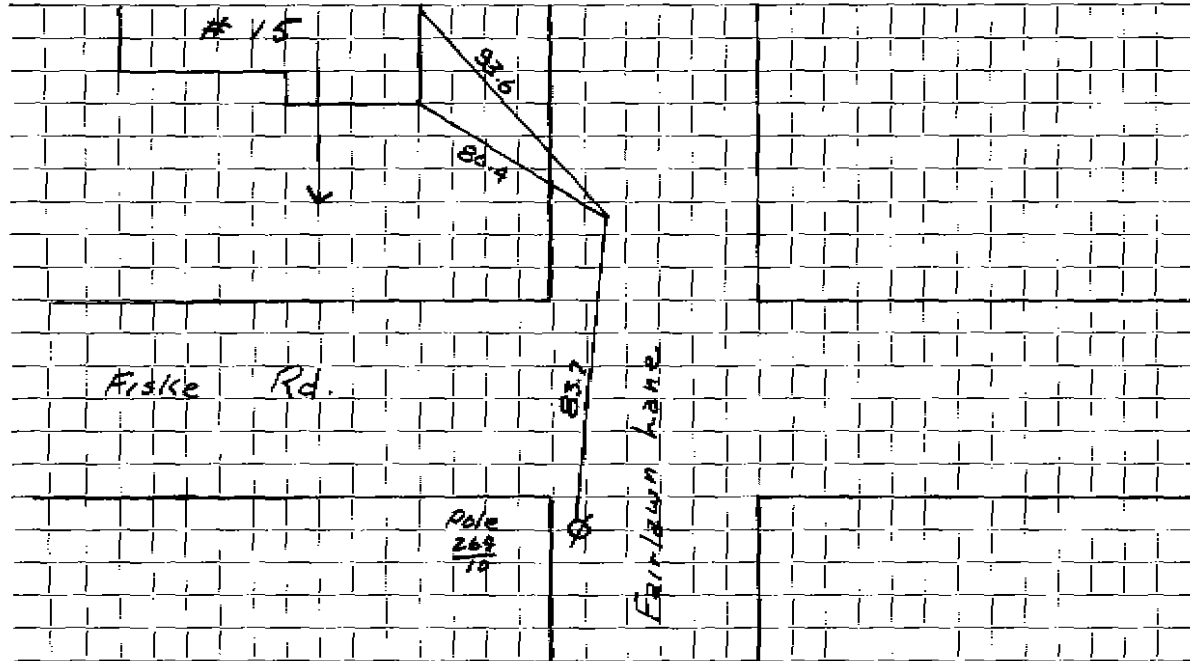

Connection made in Street. Work completed

Remarks:
.....
.....