

WATER SERVICE RECORD

#5117

Name DeVries Construction Company, Inc.

Service No. 252 nd

Address 18 Fiske Road

Location

Repair - Renewal - New Service

Com. 8-15-55

Date	Material	Amount	Total	Date	Amount
6/16/55	Labor	1 85			
	10% Overhead	19	2 04		
	50' - 3/4" copper tubing @ .3840	19 20			
	1 - 3/4" Union		1 72		
	1 - 3/4" C x 1/2 I.W.F. stop & waste	4 00			
	1 hr. trucking		75		
			27 71		
				6/16/55	Labor
					8 63
				8-15-55	21' - 3/4" Copper tubing @ .3840
					8 06
					1 - 3/4" corp-cock
					4 33
					1 - 3/4" x 3/4" C. curb-cock
					4 67
					1 box and rod
					3 90
					1 - 1/2" offset tail piece
					50
					1 - 1/2" straight tail piece
					50
					1 hr. trucking
					75
					<u>31 34</u>

Trench dug by owner

Pay Deposit Paid


NON CHARGE

DATE _____

TOWN OF LEXINGTON — BOARD OF PUBLIC WORKS

WATER DIVISION

Sketch of Service Here

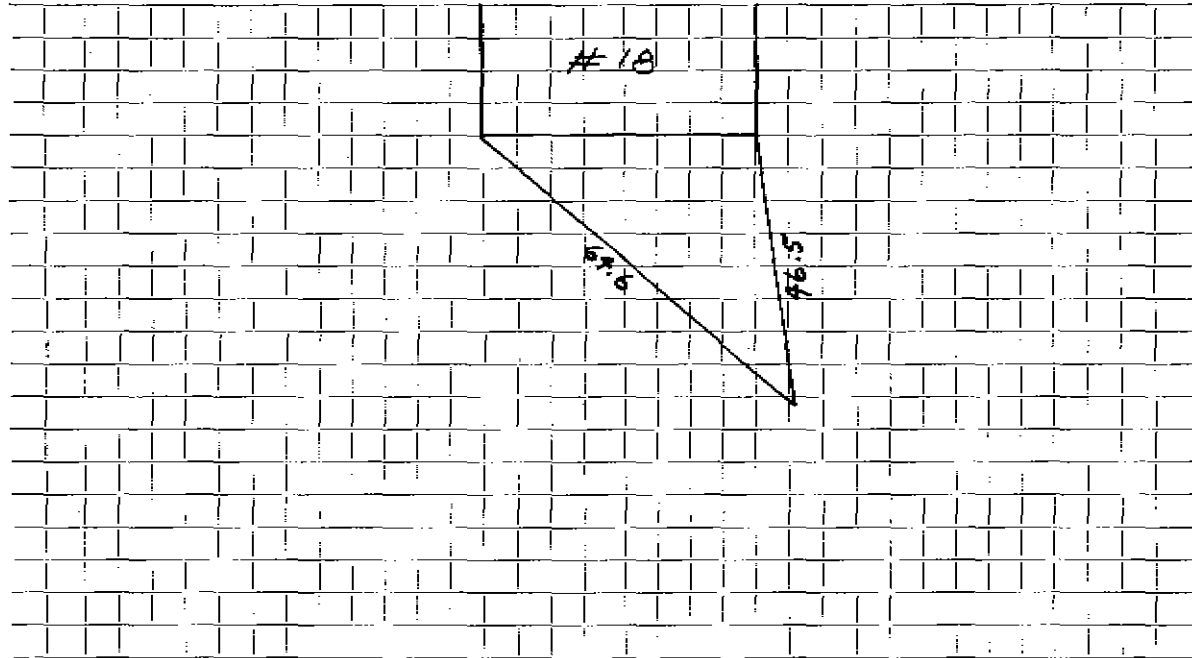

Connection made in Street. Work completed

Remarks:

.....

.....