

WATER SERVICE RECORD

Name DeVries Const. Company

Service No. 162

Address 4 Fiske Road

Location

Repair - Renewal - New Service

Com. 8-15-55

Date	Material	Amount	Total	Date	Amount
5/31/55	Labor	1 85		6-6-55	25 00
	10% Overhead	19	2 04	8-15-55	64
	70' - 3/4" Copper tubing @ .3693	25 85			<u>194 86</u>
	1 - 3/4" C x 1/2 I.W.H. stopwaste	4 00	5/31/55	Labor	5 27
	1 - 3/4" C x 3/4" C. Union 3 pts.	1 72		22' - 3/4" Copper tubing @ .3693	8 12
	1 hr. trucking		75	1 - 3/4" C. curb-cock	4 33
			<u>34 30</u>	1 - 3/4" C x 3/4" C. curb-cock	4 67
	TRENCH DUG BY OWNER			1 box and rod	3 90
				1 - 1/2 offset tail piece	50
				1 - 1/2 straight tail piece	50
				1 hr. trucking	75
					<u>28 04</u>


Deposited
Refunded
NON CHARGE

DATE _____

TOWN OF LEXINGTON — BOARD OF PUBLIC WORKS

WATER DIVISION

Sketch of Service Here

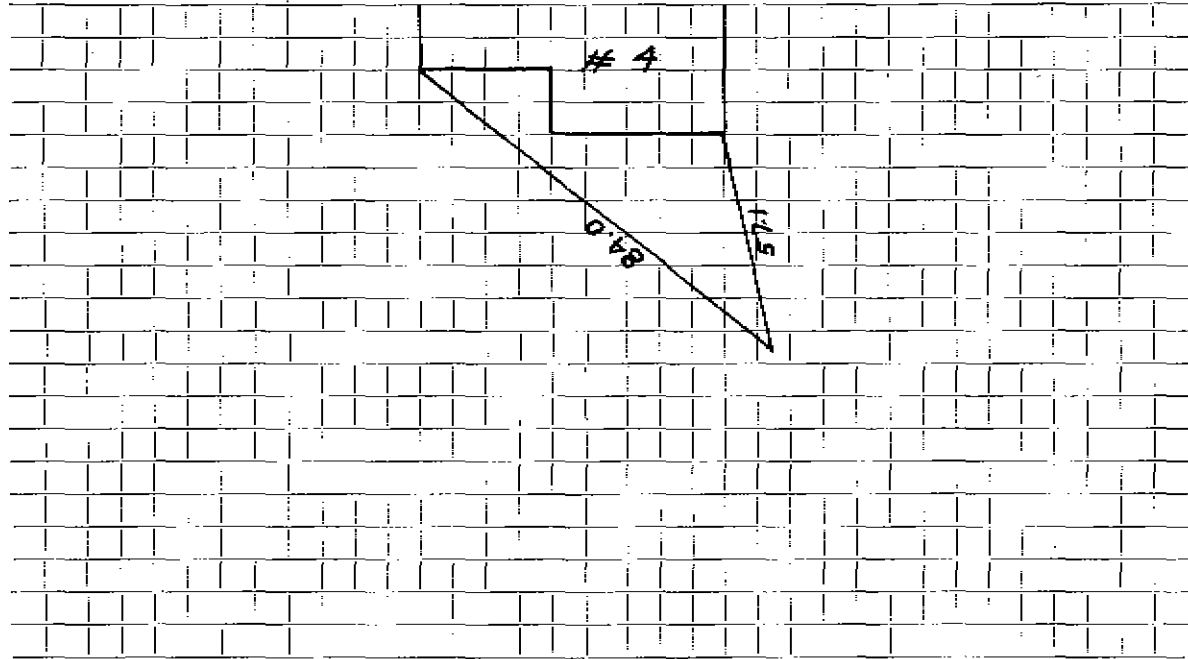

Connection made in Street. Work completed

Remarks:

.....

.....