

WATER SERVICE RECORD

Name DeVries Construction Company, Inc.

Service No. 164

Address 5 Fiske Road

Location

~~Repair - Renewal~~ - New Service

Com. 8-15-55


Date	Material	Amount	Total	Date	Amount
7/27/55	Labor	1 85		6-6-55	35 00
	10% Overhead	19	2 04	8-15-55	5 95
	80' - 3/4" copper tubing @ .3840	30 72			40 95
	2 - 3/4" Cx 3/4" union @ 1.72	3 44			
	1 - 3/4" Cx 1/2" I.W.H. stopwaste	4 00			
	1 hr. trucking	75		7/27/55	3 56
		40 95			
				18' - 3/4" copper tubing @ .3840	6 91
				1 - 3/4" corp-cock	4 33
				1 - 3/4" Cx 3/4" C curb-cock	4 67
				1 - 1/2" offset tail piece	50
				1 - 1/2" straight tail piece	50
				1 box and rod	3 90
				1 hr. trucking	75
					25 12
	<i>Trench dug by owner</i>				

DATE _____

TOWN OF LEXINGTON — BOARD OF PUBLIC WORKS

WATER DIVISION

Sketch of Service Here

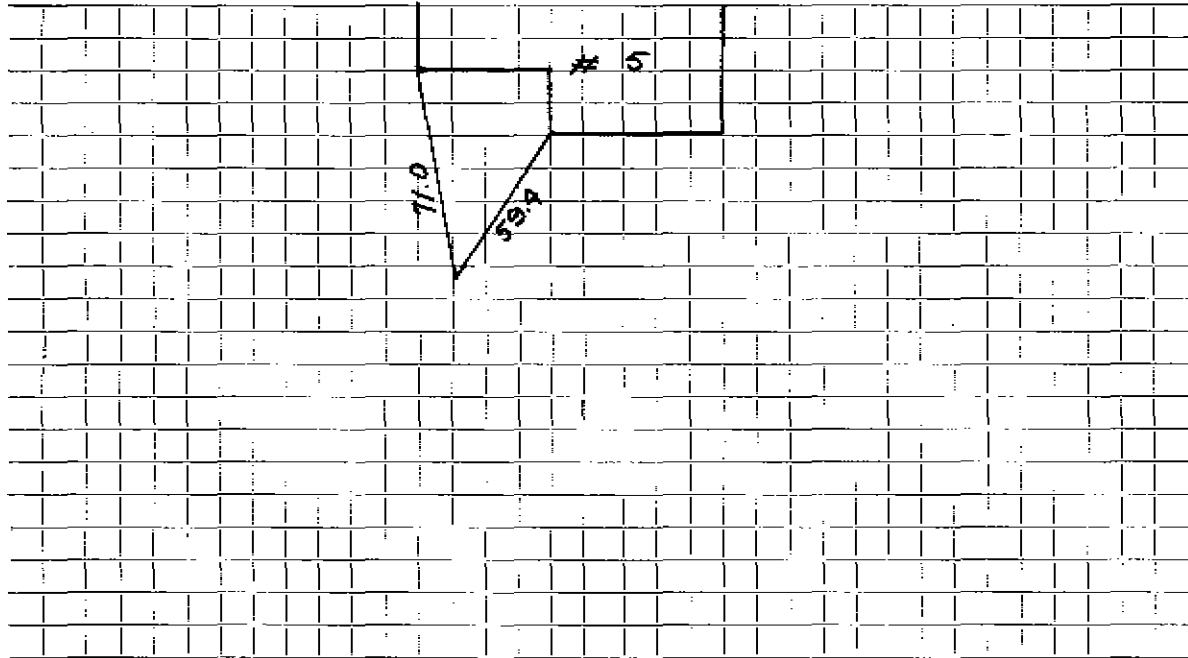

Connection made in Street. Work completed

Remarks:

.....

.....