

WATER SERVICE RECORD

Name Deyries Const. Company

Service No. 181

Address 6 Fische Road

Location

Repair—Renewal—New Service

Com. 8-15-55


Date	Material	Amount	Total	Date	Amount
5/31/55	Labor	1 85		6-6-55 = Deposited	35 00
	10% Overhead	19	2 04	8-15-55 Paid	10
	72' - 3/4" Copper tubing @ .3693	26 59		NON CHARGE	25 10
	1 - 3/4" C x 1/2" I.W.H./stop & waste	4 00		5/31/55 Labor	5 27
	1 - 3/4" C x 3/4" C. Union 3 pts.	1 72		25' - 3/4" Copper tubing @ .3693	8 12
	1 hr. trucking		75	1 - 3/4" C. corp-cock	4 33
			35 10	1 - 3/4" C x 3/4" C. curb-cock	4 67
TRENCH DUG BY OWNER				1 box and rod	3 90
				1 - 1/2" offset tail piece	50
				1 - 1/2" straight tail piece	50
				1 hr. trucking	75
					28 04
				OUTSIDE Repair #996 Work Order	
				10/30/84 1 Curb Box	

DATE _____

TOWN OF LEXINGTON — BOARD OF PUBLIC WORKS

WATER DIVISION

Sketch of Service Here

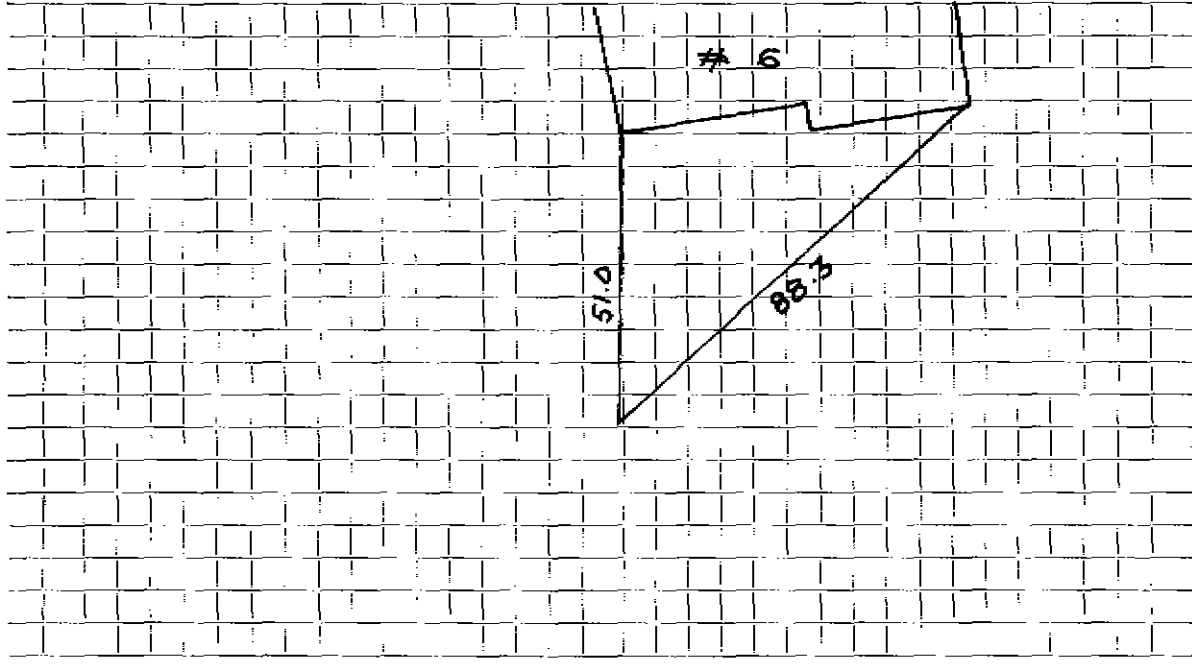

Connection made in Street. Work completed

Remarks:
.....
.....