

WATER SERVICE RECORD

Name DeVries Const. Company

Service No. 165

Address 7 Piske ~~Street~~ ^{Road}

Location

Repair ~~Renewal~~ New Service *Conn. 8-15-55*


Date	Material	Amount	Total	Date	Amount
5/26/55	Labor	1 85		6-6-55	Deposited 35 00
	10% Overhead	19	2 04	8-13-55	Refunded 6 05
	20' - 3/4" copper tubing @ .3693	22 18			<u>NON CHARGE</u> 28 95
	1 - 3/4" x 1/2 I." H. stop & waste	4 00		5/26/55	Labor 5 05
	1 hr. trucking		75		
			28 95		
					20' - 3/4" Copper tubing @ .3693 4 43
					1 - 3/4" C. comp-cock 4 33
					1 - 3/4" C x 3/4" C. curb-cock 4 37
					1 box sand red 3 90
					1 - 1/2 straight tail piece 50
					1 - 1/2 offset tail piece 50
					1 hr. trucking 75
					<u>24 13</u>
	TRINCH DUG BY OWNER				

DATE _____

TOWN OF LEXINGTON — BOARD OF PUBLIC WORKS

WATER DIVISION

Sketch of Service Here

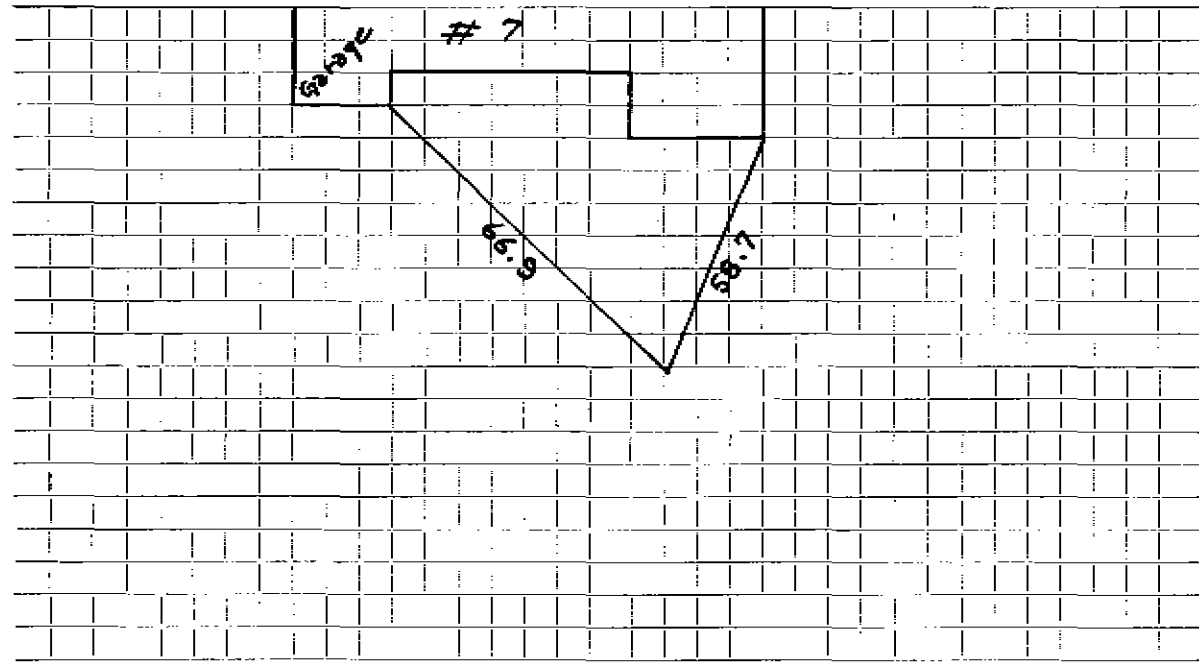

Connection made in Street. Work completed

Remarks:
.....
.....