

WATER SERVICE RECORD

Name LeVrier Const. Company

Service No. 160

Address 8 Piche Road

3213

Location

Repair—Renewal—New Service

Com. 8-15-55


Date	Material	Amount	Total	Date	Amount
5/31/55	Labor	1.35		6-6-55	Deposited 35.00
	10% Overhead	.19	2.54	8-15-55	Refunded (6.25)
	60' - 3/4" Copper tubing	3.3693	22.16		NON CHARGE
	1 - 3/4" C x 3/4" I. W. E. stopcock	4.00	26.90	5/31/55	Labor 5.97
	1 hr. trucking		75		31' - 3/4" Copper tubing
			26.95		3.3693 7.76
					1 - 3/4" C. comp-cock
					4.33
					1 - 3/4" C x 3/4" C. curb-cock
					4.37
					2 bolt and nut
					3.90
					1 - 1/2 straight tail piece
					50
					1 - 1/2 offset tail piece
					50
					1 hr. trucking
					75
					97.68

DATE _____

TOWN OF LEXINGTON — BOARD OF PUBLIC WORKS

WATER DIVISION

Sketch of Service Here

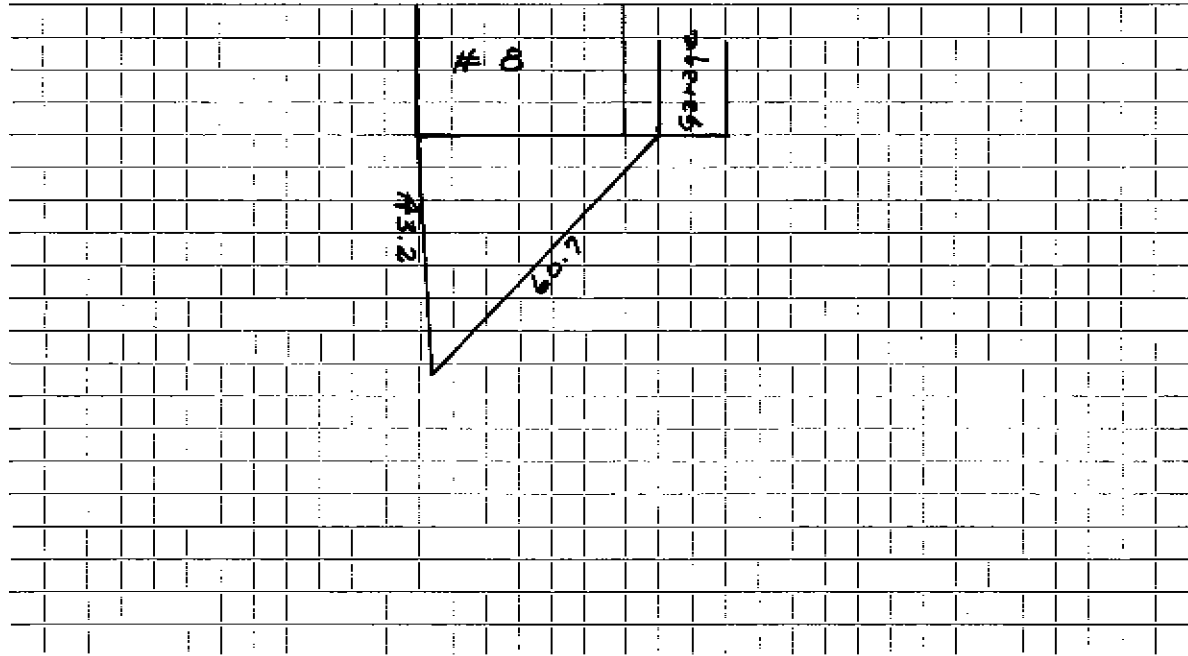

Connection made in Street. Work completed

Remarks:
.....
.....