

WATER SERVICE RECORD

Name Devries Const. Company

Service No.

Address 8 Ficke ~~Street~~ Road

Location

Repair ~~Renewal~~ New Service

Com. 8-15-55

| Date | Material | Amount | Total | Date | Amount |
|---------|------------------------------------|--------|----------------------------------|--------------------------------|-------------------------|
| 5/26/55 | Labor | 1 85 | | 6-6-55 | Deposited 35 00 |
| | 10% Overhead | 19 | 2 04 | 8-15-55 | Paid 10 |
| | 78' - 3/4" Copper tubing @ .3693 | 28 59 | | | <u>NON CHARGE</u> 35 10 |
| | 1 - 3/4" C x 1/2" I.W.E. st. @ .40 | 4 00 | 5/26/55 | Labor | 5 05 |
| | 1 - 3/4" C x 3/4" C. Union @ .172 | 1 72 | 10' - 3/4" Copper tubing @ .3693 | | 3 69 |
| | 1 hr. trucking | | 75 | 1 - 3/4" C. comp-cock | 4 33 |
| | | | 35 10 | 1 - 3/4" C x 3/4" C. curb-cock | 4 67 |
| | | | | 1 box sand and red | 3 90 |
| | | | | 1 - 1/2 offset tail piece | 50 |
| | | | | 1 - 1/2 straight tail piece | 50 |
| | | | | 1 hr. trucking | 75 |
| | | | | | 23 39 |


PAID BY OWNER

DATE _____

TOWN OF LEXINGTON — BOARD OF PUBLIC WORKS

WATER DIVISION

Sketch of Service Here

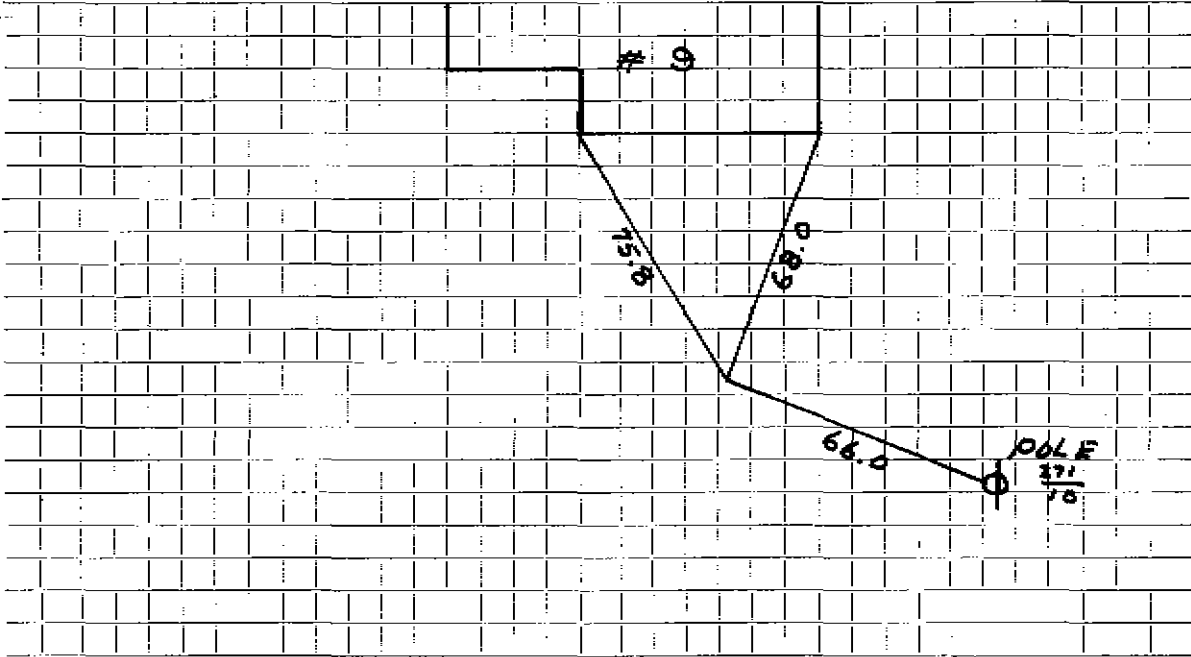

Connection made in Street. Work completed

Remarks:

.....

.....