

WATER SERVICE RECORD

Name Joachim R. Sinek

Service No. ~~48~~ 49

Address 11-13 Fletcher Avenue

Location

~~Repair~~—Renewal—~~New Service~~ W.O. #4402

MAR 15 1976


Date	Material	Amount	Total	Date	Amount
10/24/75	Labor	59.43		11-11-75	Deposit 335.00
	10% O.H.	5.94	65.37	3-15-76	Refund 114.70
27'	3/4" Copper tubing @.67		18.09		110.30
1	3/4" x 5/8" Wheel Handle		15.34		
1	5/8" Bent Tail piece		2.00		
1	hr. Town Shovel @6.50		6.50		OUTSIDE W.O. 5732
1	hr. Trucking @3.00		3.00	9/9/77	Labor 149.45
			110.30		2 36" x 6" Transite Nipple 9.90
					1 6" Coupling 2.46
					1 Ton Cold Patch 15.90
					2 hrs. Trucking 6.00
					2 hrs. Town Shovel 13.00
					211.66

DATE _____

TOWN OF LEXINGTON — BOARD OF PUBLIC WORKS

WATER DIVISION

Sketch of Service Here

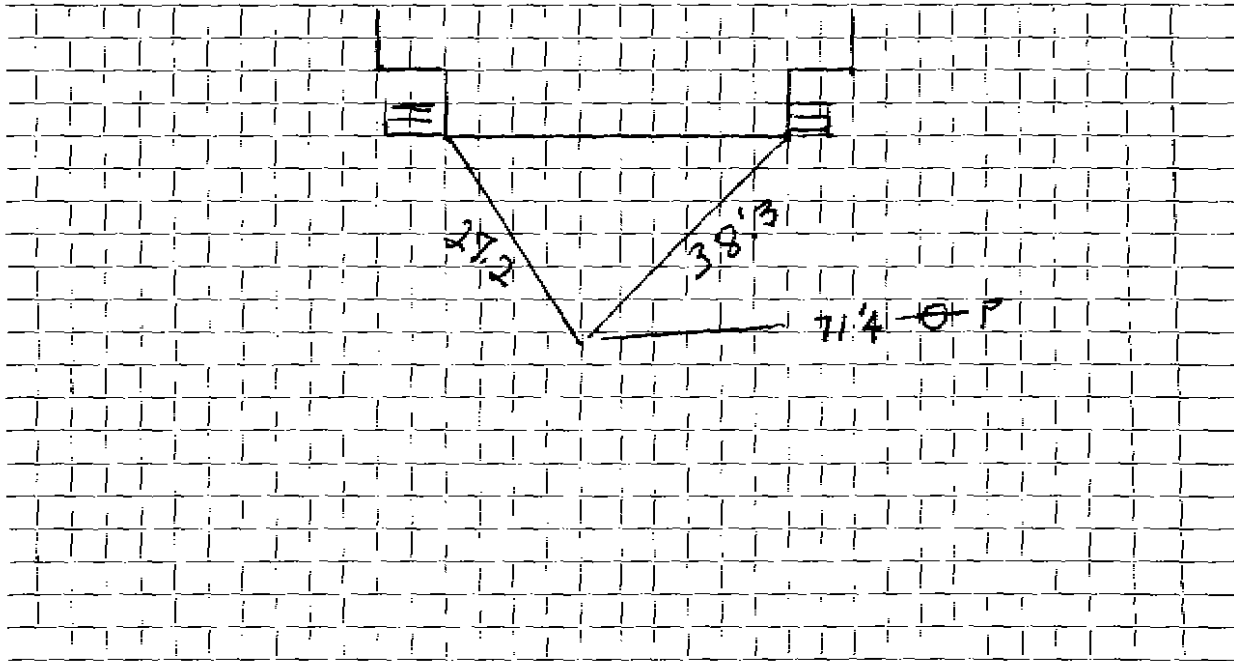

Connection made in Street. Work completed

Remarks:

.....

.....