

WATER SERVICE RECORD

Service No. 63

Name *William Stygles*

Address *5-17 Fletcher Avenue*

Location

Repair—Renewal—New Service W.O. #1521

FEB 10 1975


Date	Material	Amount	Total	Date	Amount	
<i>11-26-73</i>				<i>11-27-73</i>	<i>Deposit</i>	<i>75.00</i>
	<i>Labor</i>	<i>30.50</i>				
	<i>10% O.H.</i>	<i>3.05</i>	<i>\$33.55</i>			
<i>27'</i>	<i>3/4" Copper tubing @.98</i>		<i>24.46</i>	<i>11/26/69</i>		
<i>1</i>	<i>3/4" Wheel valve</i>		<i>11.99</i>	<i>28'</i>	<i>3/4 COPPER</i>	
<i>1</i>	<i>hr Trucking</i>		<i>3.00</i>	<i>1</i>	<i>3/4 Adpt.</i>	
				<i>1</i>	<i>3/4 Carb Cock</i>	
					<i>Box + Rod</i>	
		<i>Total</i>	<i>\$75.00</i>			

DATE _____

TOWN OF LEXINGTON — BOARD OF PUBLIC WORKS

WATER DIVISION

Sketch of Service Here

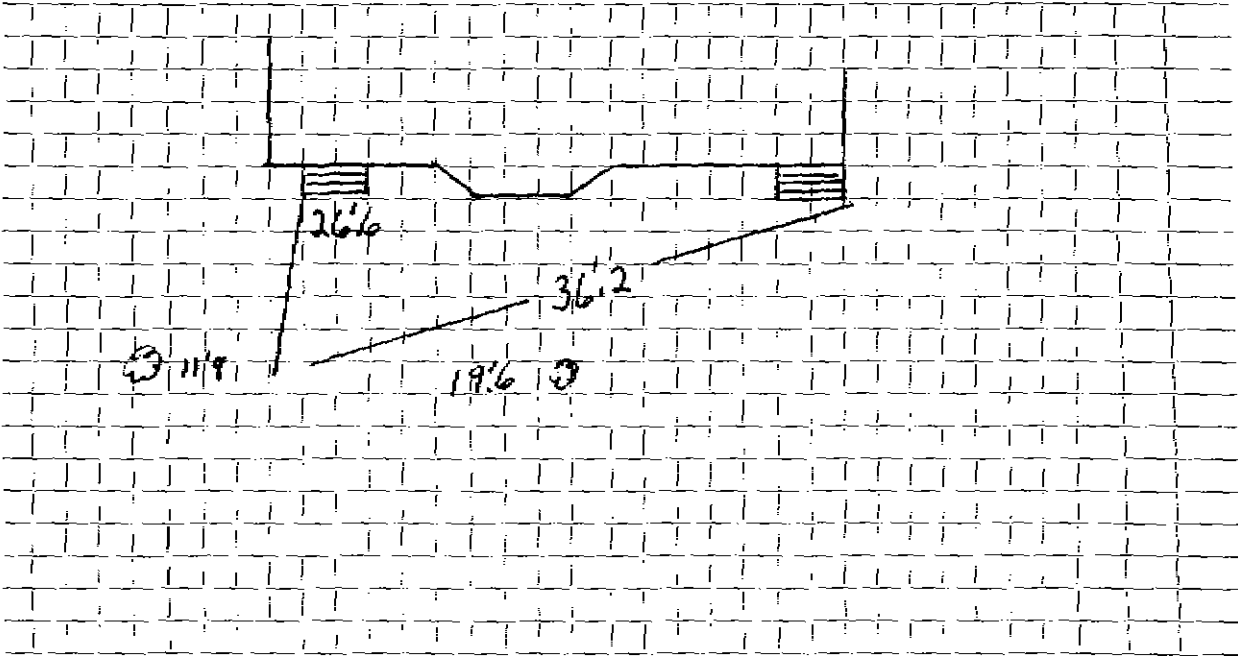

Connection made in Street. Work completed

Remarks:

.....

.....