

WATER SERVICE RECORD

Name Robert May

Service No. 44

Address 16 Fletcher Avenue

Location

~~Repair~~—Renewal—~~New Service~~ W.O. #5931


FEB 13 1978

Date	Material	Amount	Total	Date	Amount
11/28/77	Labor	18.19		11-25-77	Deposit 25.00
	10% O.H.	1.81	20.00	2-13-77	Refund 2.33
31'	3/4" Copper tubing @.83		25.73		78.67
1	3/4" Wheelhandle		15.98		OUTSIDE W.O. #5940
1	3/4" x 1/2" Bushing		1.46	11/28/77	Labor 29.54
1	hr. Trucking @3.00		3.00	6'	3/4" Copper tubing 4.98
1	hr. Backhoe @6.50		6.50	1	3/4 x 3/4 Adapter 6.25
			72.67	1	3/4 Curb 15.07
				1	Box & Rod 13.41
				1	hr. Trucking 3.00
				1	hr. Backhoe 6.50
					78.75

DATE _____

TOWN OF LEXINGTON — BOARD OF PUBLIC WORKS
WATER DIVISION

Sketch of Service Here

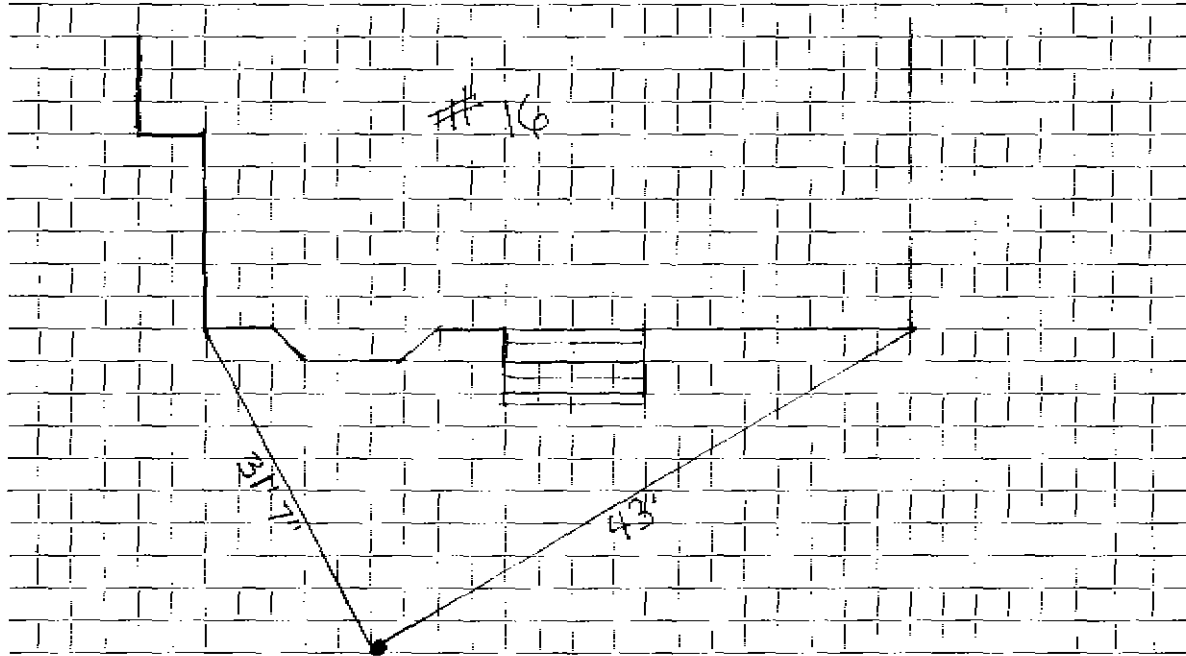

Connection made in Street. Work completed

Remarks:
.....
.....