

### WATER SERVICE RECORD

#5091

Name Ralph Witthus

Service No. 285

Address 20 Fletcher Avenue

Location

~~Repair-Renewal-New Service~~


Date	Material	Amount	Total	Date	Amount
10/8/56	Labor	43 20		9-14-56	Deposit \$100 00
	10% overhead	4 32	47 52	12-31-56	Refund 31 47
	30' - 3/4" Copper tubing @ .4850	14 55			NON CHARGE 68 53
	1 - 3/4" Cx 1/2 I.W.H. Stop & Waste	4 96		10/8/56	Labor 14 28
	2 hrs. Trucking @ .75	1 50			10' - 3/4" Copper tubing @ .4850 4 85
			68 53		1 - 3/4" C.Curb Cock 5 94
					1 Box & Rod 4 62
					1 - 3/4" Corp Adapter 2 08
					<u>31 77</u>

DATE \_\_\_\_\_

TOWN OF LEXINGTON — BOARD OF PUBLIC WORKS

WATER DIVISION

Sketch of Service Here

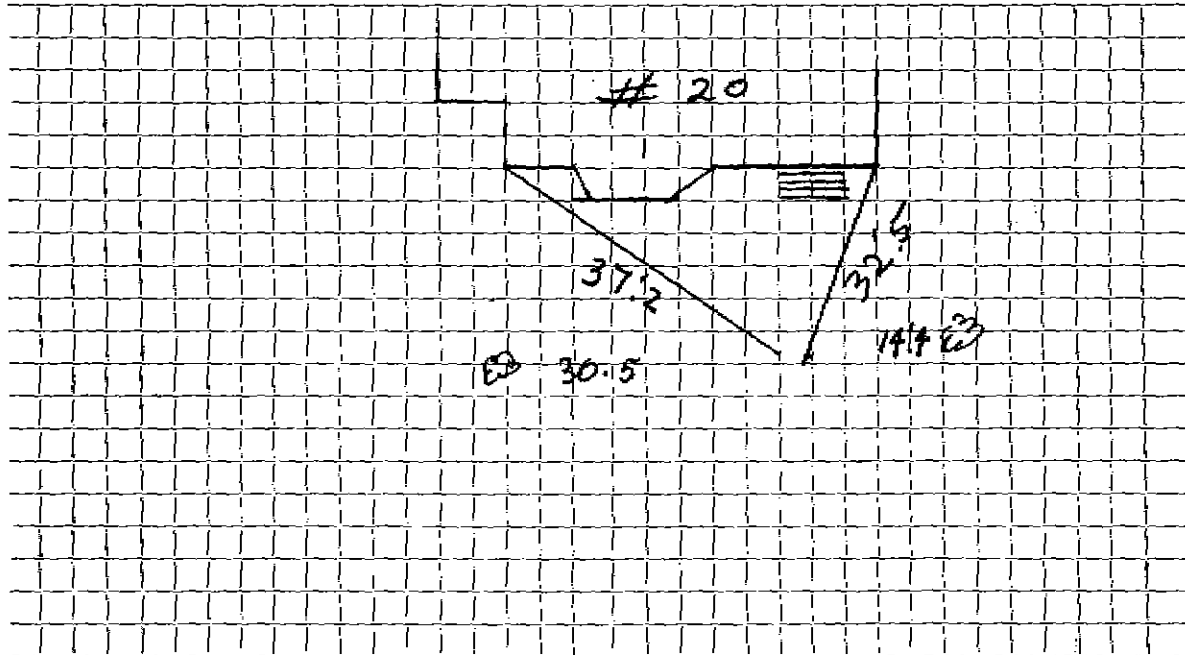

Connection made in ..... Street. Work completed .....

Remarks: .....

.....

.....