

WATER SERVICE RECORD

1094

Service No. 119

Name David Dieter

Address 21 Fletcher Avenue

Location

~~Repair~~ - Renewal - ~~New Service~~ W.O. #8261

Comm 2-10-64


| Date     | Material                         | Amount | Total | Date     | Amount                        |       |
|----------|----------------------------------|--------|-------|----------|-------------------------------|-------|
| 10/23/63 | Labor                            | 41 12  |       | 10-23-63 | 100 00                        |       |
|          | 10% O.H.                         | 4 11   | 45 23 | 2-10-64  | 15 99                         |       |
|          | 33' 3/4" Copper Tubing @ .42     |        | 13 86 |          | 84 01                         |       |
|          | 1 3/4" Cx 1/2 I.W.H. top & Waste |        | 6 17  |          |                               |       |
|          | 2 Yards Loam @ 3.00              |        | 6 00  | 10/23/63 | Labor                         | 29 88 |
|          | 1 1/4 Hrs. Town Shovel @ 6.50    |        | 9 75  |          | 24' 3/4" Copper Tubing @ .42  | 10 08 |
|          | 1 Hr. Trucking @ 3.00            |        | 3 00  |          | 1 3/4" C Corp Cock            | 4 91  |
|          |                                  |        | 84 01 |          | 1 3/4" C Curb Cock            | 6 28  |
|          |                                  |        |       |          | 1 Bow & Rod                   | 4 90  |
|          |                                  |        |       |          | 1 1/2 Straight Tailpiece      | 50    |
|          |                                  |        |       |          | 1 1/2 Offset Tailpiece        | 50    |
|          |                                  |        |       |          | 1 1/2 Hrs. Town Shovel @ 6.50 | 9 75  |
|          |                                  |        |       |          | 1 Hr. Trucking @ 3.00         | 3 00  |
|          |                                  |        |       |          | 23 X 3 Patch                  | 23 00 |
|          |                                  |        |       |          |                               | 92 80 |

DATE \_\_\_\_\_

TOWN OF LEXINGTON — BOARD OF PUBLIC WORKS

WATER DIVISION

Sketch of Service Here

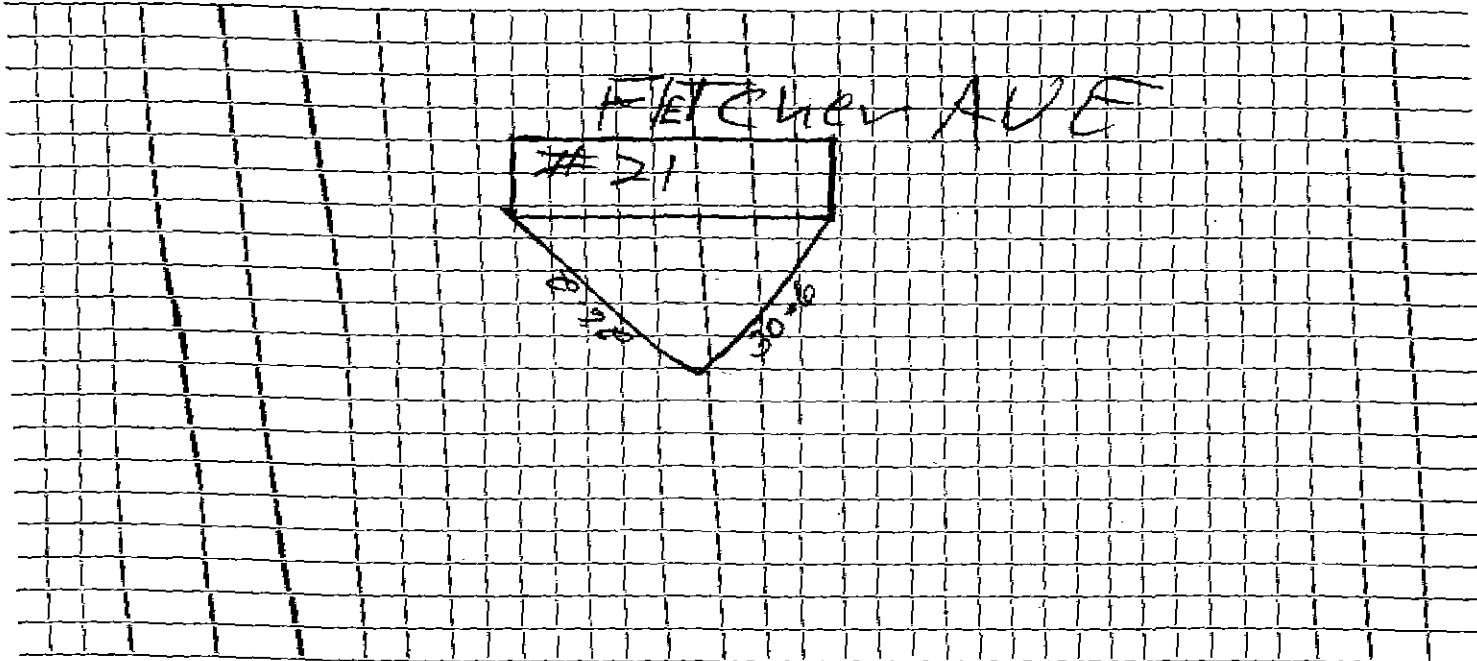

Connection made in ..... Street. Work completed .....

Remarks: .....  
.....  
.....