

WATER SERVICE RECORD

Name Robert Beattie

Service No. 20

Address 22 Fletcher Avenue

#6839

Location

~~Repair~~ ~~Renewal~~ ~~New Service~~ W.O. # 8771


OCT 4 1971

Date	Material	Amount	Total	Date	Amount
8/9/71	Labor	139 28		7-28-71	Deposit 350 00
8/10/71	"	52 23	191 51	10-4-71	Retained 12 17
	10% O.H.		19 15		232 83
88'	3/4" Copper pipe .79		69 52		
1	3/4" Union		3 05	8/19/71	OUTSIDE Labor 87 05
1	3/4" Wheel Valve		9 30	8/24/71	" 24 53
2	Yds. Loam 3.50		7 00		6' 3/4" Copper pipe .79 4 74
3	Lbs. Seed 1.10		3 30		1' 3/4" Curb cock 11 32
3	Hrs. Trucking 3.00		9 00		1/2' 3/4" Adapter 2 76
4	Hrs. Shovel 6.50		26 00		1 Ton cold patch 8.00 2 00
			337 83		1 Ton hot top 7 45
				2 1/2	Hrs. Trucking 3.00 7 50
				1	Hrs. Shovel 4.00 4 00
				1	Hr. compressor 3.00 1 50
				1	Hr. loader 4.00 2 00
				1	Hr. Roller 2 00
					Trailer 2 00
					158 85

DATE _____

TOWN OF LEXINGTON -- BOARD OF PUBLIC WORKS
WATER DIVISION

Sketch of Service Here

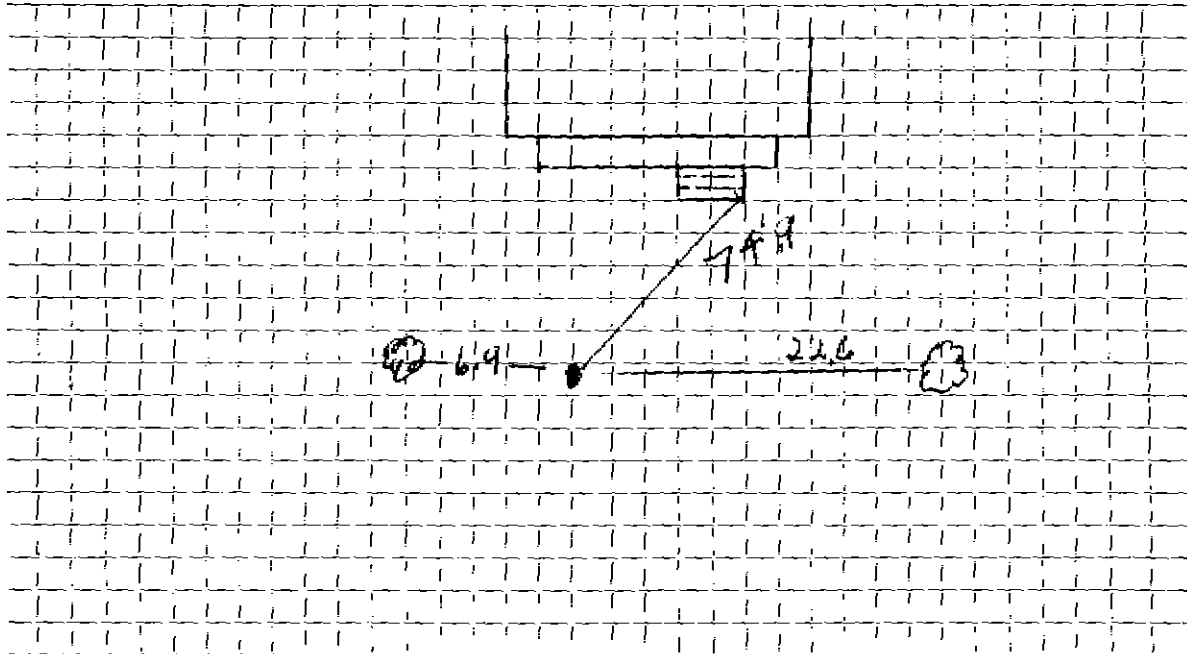

Connection made in Street. Work completed

Remarks:
.....
.....