

#5663

WATER SERVICE RECORD

Name Willis R. Anderson

Service No. 96

Address 23 Fletcher Avenue

# 518

Location

Remarks: General—New Service

Comm. 11-19-56

Date	Material	Amount	Total	Date	Amount
6/1/56	Labor	3 90		5-11-56	Deposit 50 00
	10% overhead	39	4 29	11-19-56	Refund * 15 75
	50' - 3/4" Copper tubing @ \$ .4850-24	25	25		NON CHARGE 34 25
	1 - 3/4Cx1/2 I.W.H. Stop & Waste		4 96	6/1/56	Labor 3 90
	1 hr. trucking		75	24' - 3/4" Copper tubing @ .4850	11 64
			34 25	1 - 3/4" G. Corp Cock	4 64
				1 - 3/4" G. Curb Cock	5 94
				1 Box & Rod	4 62
				1 - 1/2 Straight tailpiece	50
				1 - 1/2 Offset tailpiece	50
					31 74


\* \$8.86 applied to S.W.C #48

DATE \_\_\_\_\_

TOWN OF LEXINGTON — BOARD OF PUBLIC WORKS

**WATER DIVISION**

Sketch of Service Here

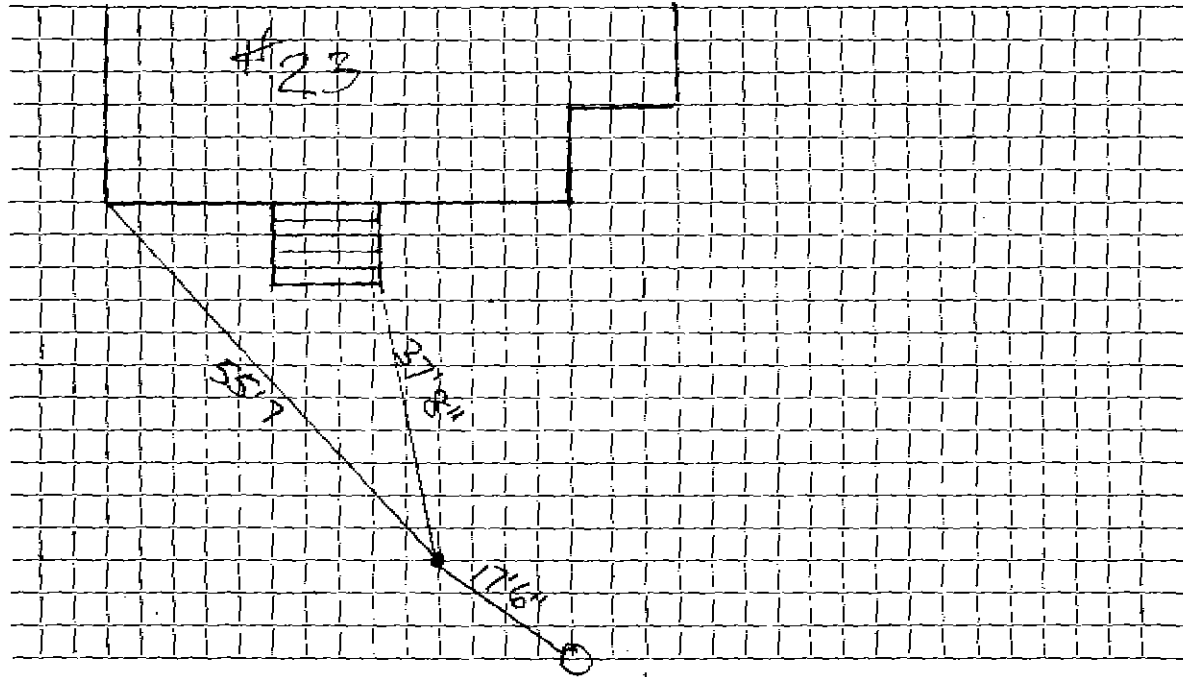

Connection made in ..... Street. SM H Work completed .....

Remarks: .....

.....

.....