

WATER SERVICE RECORD

Name Thelma Brigham

Service No. 89

Address 24 Fletcher Avenue

3380

7102, 7108

Location _____

~~WATER~~ Renewal ~~NECESSARY~~ W.O. #896

MAR 14 1966


Date	Material	Amount	Total	Date	Amount
9-2-65	Labor	70.00		8-30-65	Deposit 150.00
	10% O.H.	7.00	77.00	3-14-66	Retund 38.74
28'	3/4" Copper tubing @.42		11.76		111.26
1	hr. Town Truck		3.00		GURE TO MAIN
3	hrs. Town Tractor @6.50		19.50	6'	3/4" Copper tubing @.42 2.52
			111.26		5 x 3 Patch 5.00
				1/2	yd Loam @3.00 1.50
					9.02

DATE _____

TOWN OF LEXINGTON — BOARD OF PUBLIC WORKS

WATER DIVISION

Sketch of Service Here

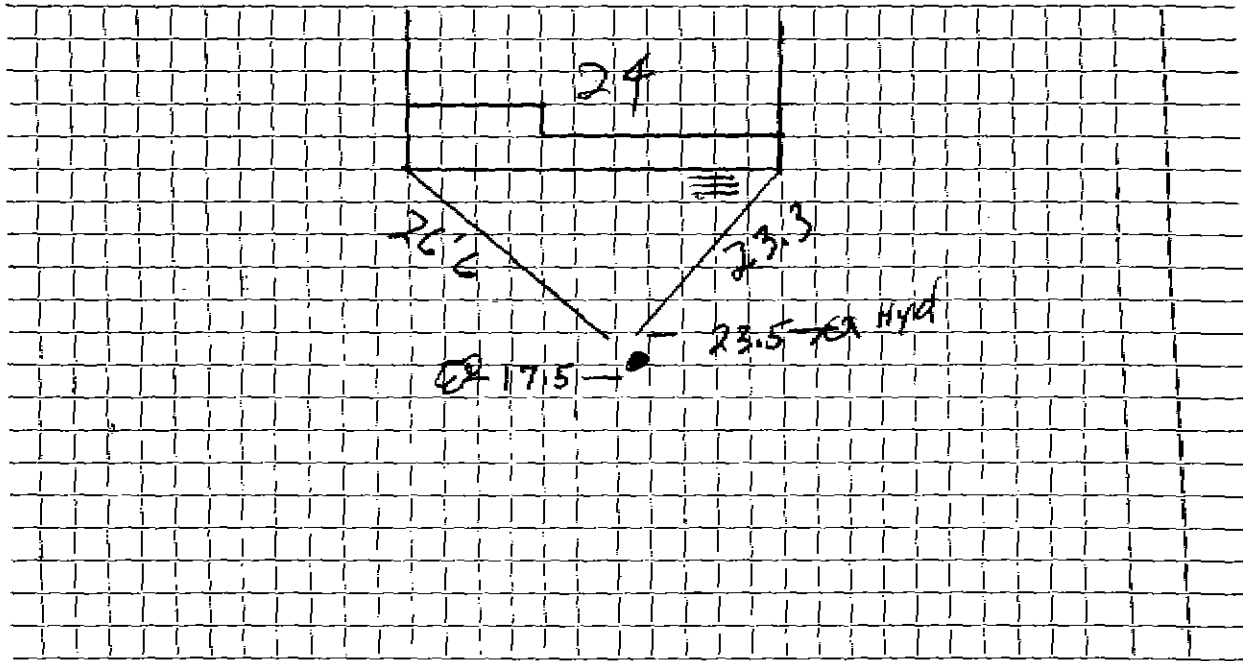

Connection made in Street. Work completed

Remarks:

.....
.....