

WATER SERVICE RECORD

Name Harry R. Byrn

Service No. 13

Address 25 Fletcher Avenue

6356, 7375

Location Lexington

Report ~~Renewal~~ - New Service

COM. 4-28-52


Date	Material	Amount	Total	Date	Material	Amount
3/13/52	Labor	5 52	5 52	2-5-52	Deposited	60 00
	10% overhead		55	24 52	Deposited	5 05
	44' - 3/4" copper tubing @ .3439	15 13			<u>NO CHARGE</u>	54 95
	1 - 3/4" C x 1/2 I.W.H. stop & waste	4 00		3/13/52	Labor	19 45
	2 hrs. Littlefield shovel		14 00		26' - 3/4" copper tubing @ .3439	8 94
	1 hr. trucking		75		1 - 3/4" C. corp-cock	4 33
	patching 15 x 3		15 00		1 - 3/4" C x 3/4" C. curb-cock	4 67
			54 95		1 - box and rod	4 52
					1 - 1/2 offset tail piece	50
					1 - 1/2 straight tail piece	50
					2 hrs. littlefield shovel @ 7.00	14 00
					1 hr. trucking	75
						57 66

DATE _____

TOWN OF LEXINGTON — BOARD OF PUBLIC WORKS

WATER DIVISION

Sketch of Service Here

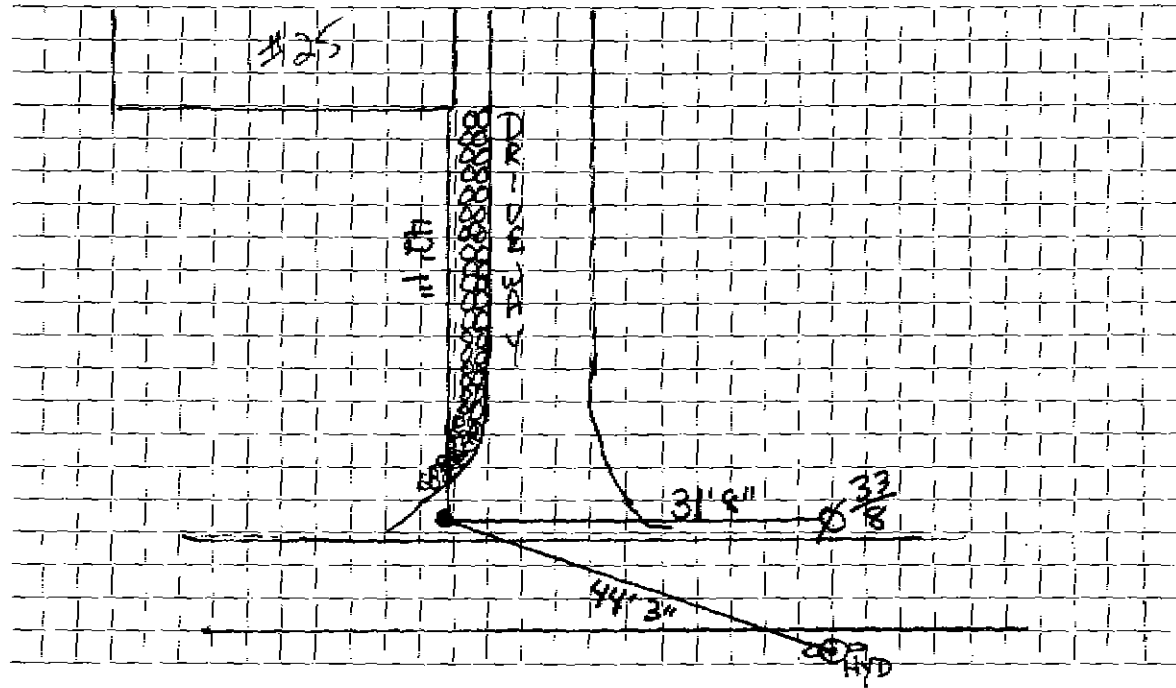

Connection made in Street. Work completed

Remarks:
.....
.....