

WATER SERVICE RECORD

#4699

Name John D. MacNeil

Service No. 68

Address 28 Fletcher Avenue

Location

~~Repair~~ - ~~Renewal~~ - ~~New Service~~

Comm. 7/22/57


Date	Material	Amount	Total	Date	Amount
4/29/57	Labor	4 08		4-15-57	Deposit \$ 35 00
	10% overhead	41	4 49	7-22-57	Refund \$ 9 58
	36' - 3/4" Copper tubing @ .4228	15 22			NON CHARGE \$ 25 42
	1 - 3/4" Cx 1/2 I.W.H. Stop & Waste	4 96		Labor	2 04
	1 hr. Trucking		75	6' - 3/4" Copper tubing @ .4228	2 54
			25 42	1 - 3/4" C. Corp Cock	4 64
				1 - 3/4" C. Curb Cock	5 94
				1 Box & Rod	4 62
					19 78
				* Applied to S.M.C. # 45	

DATE _____

TOWN OF LEXINGTON — BOARD OF PUBLIC WORKS

WATER DIVISION

Sketch of Service Here

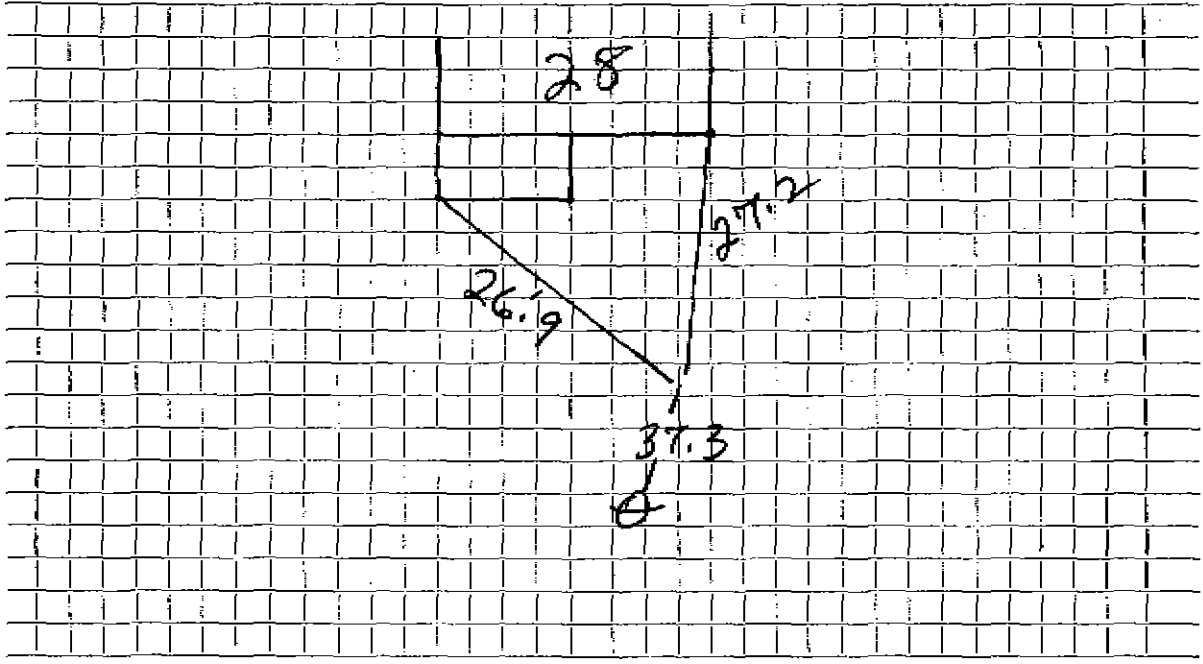

Connection made in Street. Work completed

Remarks:
.....
.....